


T.17S.R.4 W.W.M.

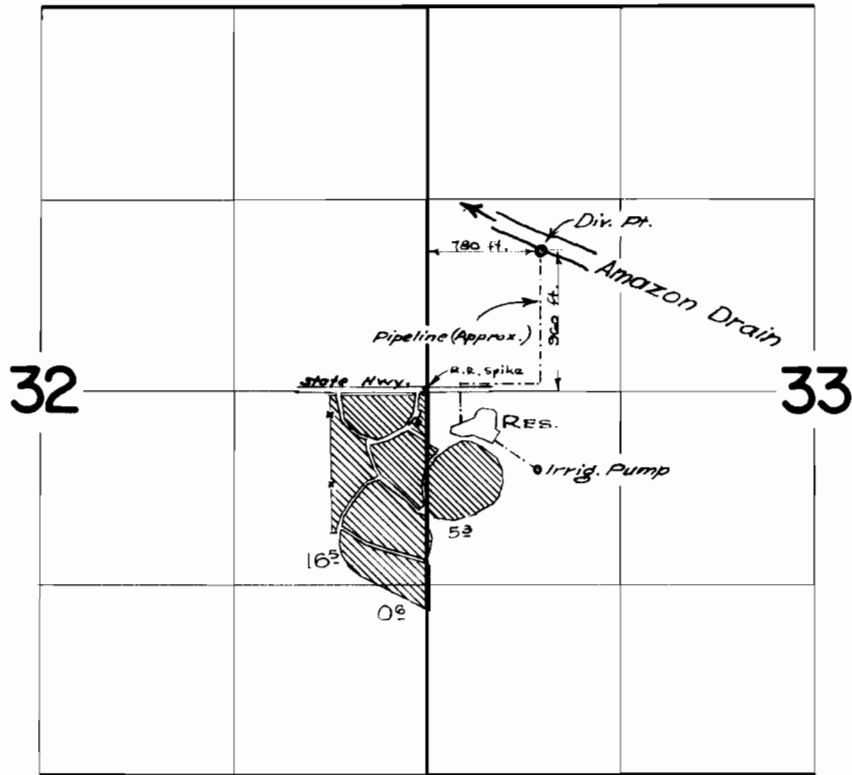

FINAL PROOF SURVEY UNDER

R-39063 R-3867
Application No. 39064 Permit No. 29167
IN NAME OF

LANE MEMORIAL GARDENS

Surveyed May 3, 1965, by *R.H. Jackson*