


T. 16 S. R. 2 E. W. M.

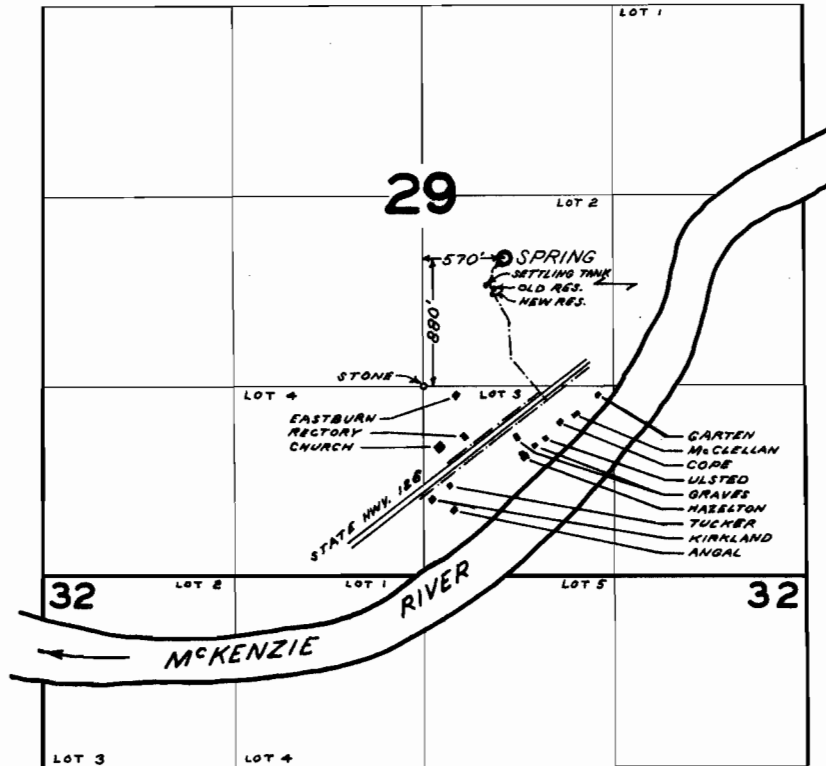

FINAL PROOF SURVEY UNDER

Application No. 33906 Permit No. 26712

IN NAME OF

J. EARL McCLELLAN

Surveyed Aug. 31 1966, by L. GOULD