


T. 16 & 17 S. R. 1 & 2 E. W. M.

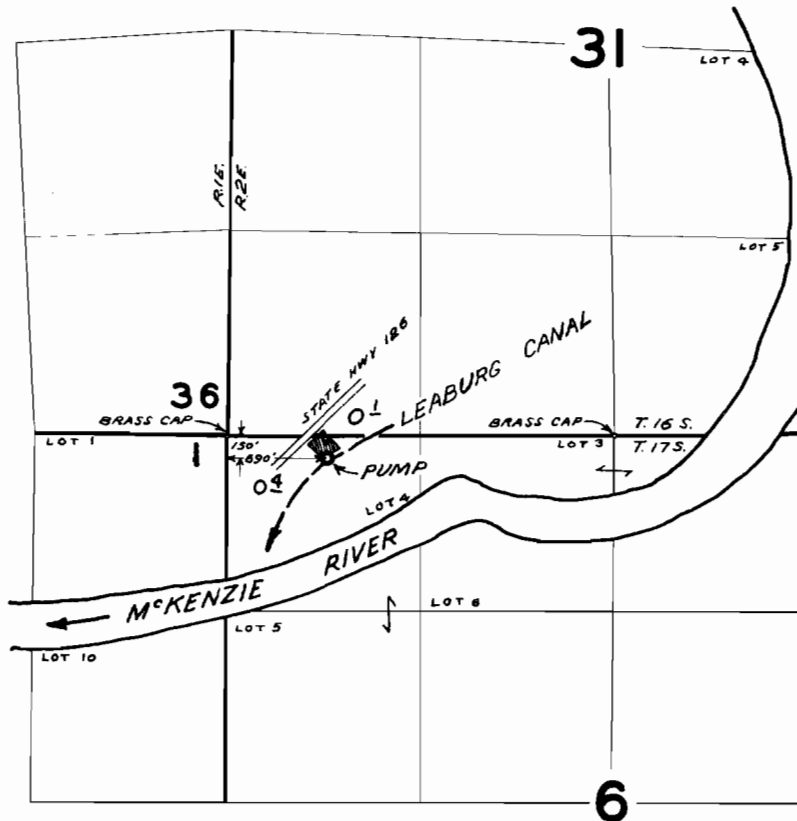

FINAL PROOF SURVEY
UNDER

Application No. 41696 Permit No. 31134

IN NAME OF

PAUL J. & PEARL M. RIGGINS

Surveyed AUG. 30, 1966, by L. GOULD