


T.18S. R.2W. W.M.

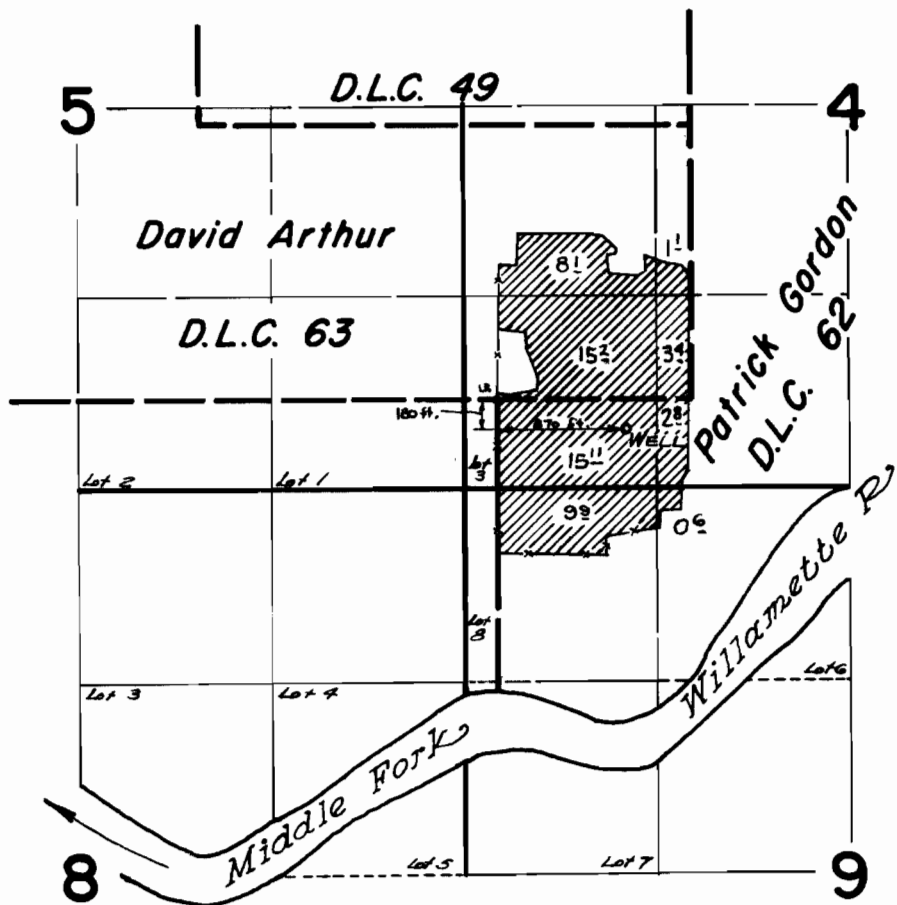

FINAL PROOF SURVEY
UNDER

Application No. G-2163 Permit No. G-1995
IN NAME OF

TRUMAN CHASE & LLOYD WHITEAKER

Surveyed May 6, 1965, by [Signature]