


T. 14 S. R. 9 W. W. M.

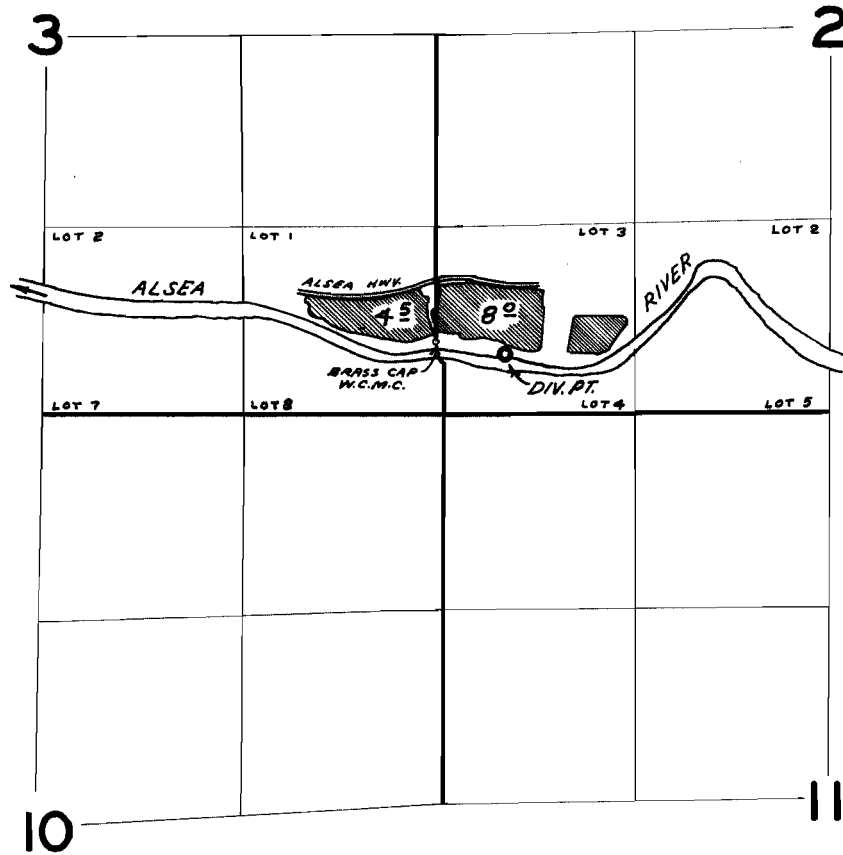

FINAL PROOF SURVEY
UNDER

Application No. 40137 Permit No. 29920
IN NAME OF

P. B. BOYSEN

Surveyed AUG. 24 1966, by L. GOULD