


T.13S.R11W.W.M.

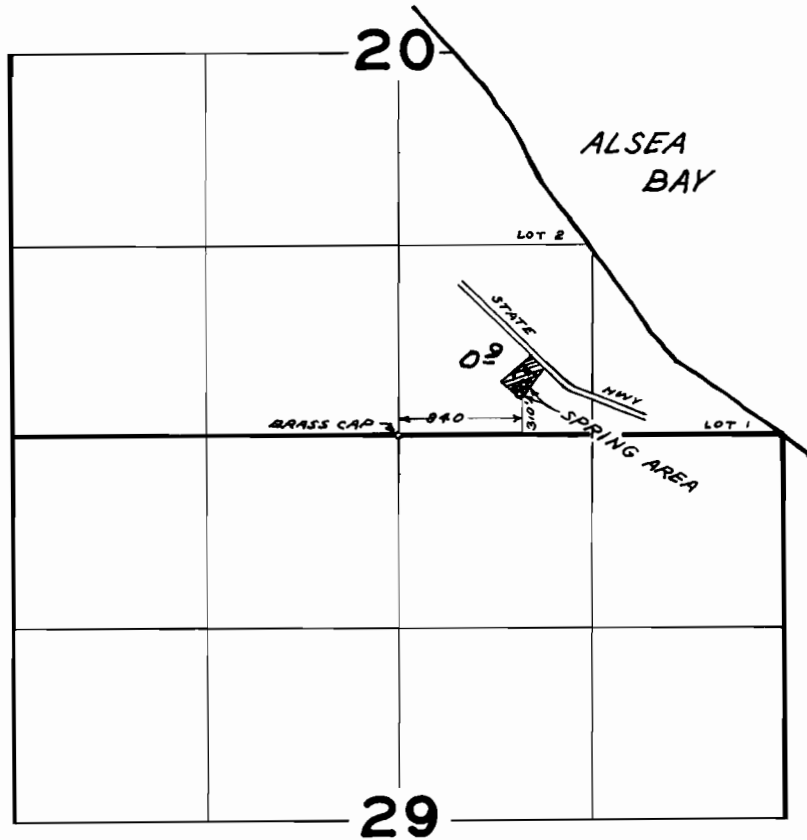

FINAL PROOF SURVEY
UNDER

Application No. 41395 Permit No. 30921
IN NAME OF

C.E. AND BERNICE GUNDERSEN

Surveyed AUG. 24, 1966, by L. GOULD