


T.10&11S.R.1W.W.M.

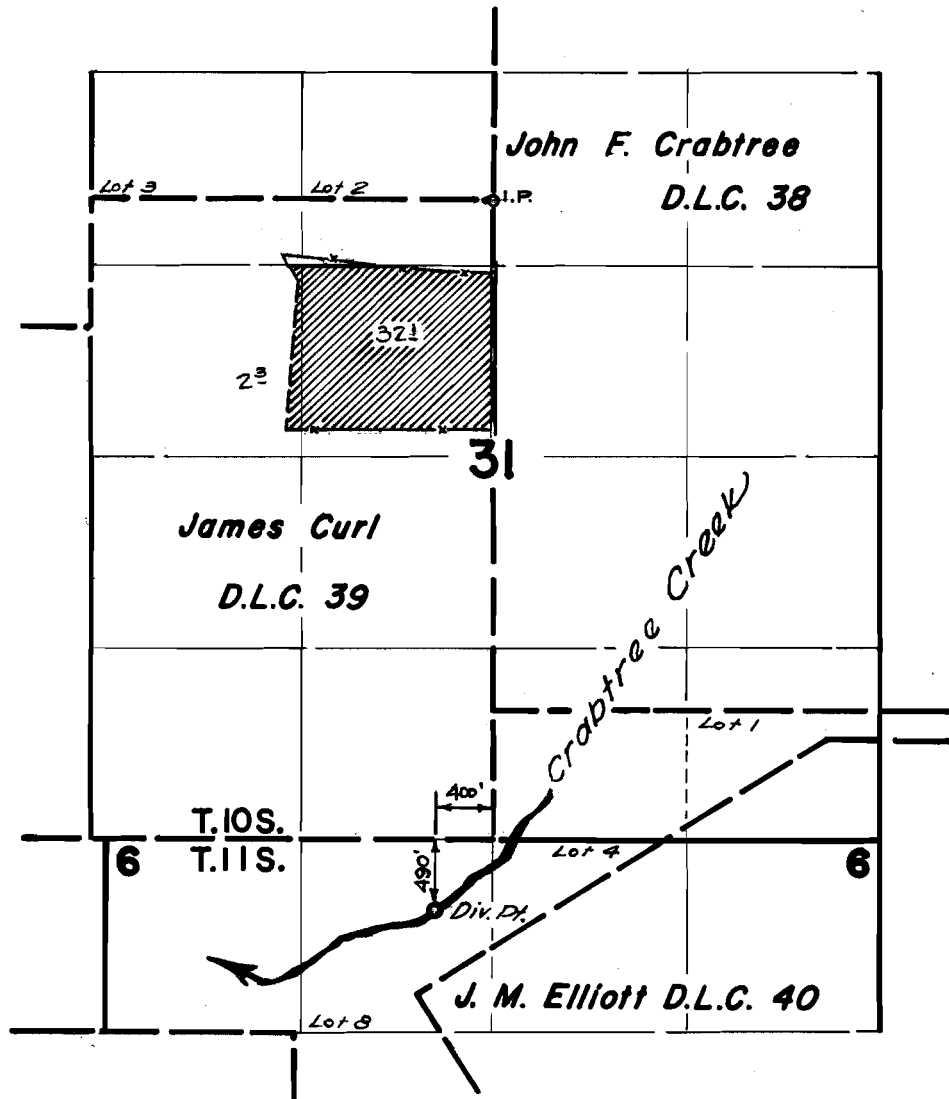

FINAL PROOF SURVEY
UNDER

Application No. 40588... Permit No. 30239...
IN NAME OF

RAYMOND & BETTY KALINA

Surveyed April 6 1966, by *R. Jackson*