


T. 27 S. R. 38 E. W. M.

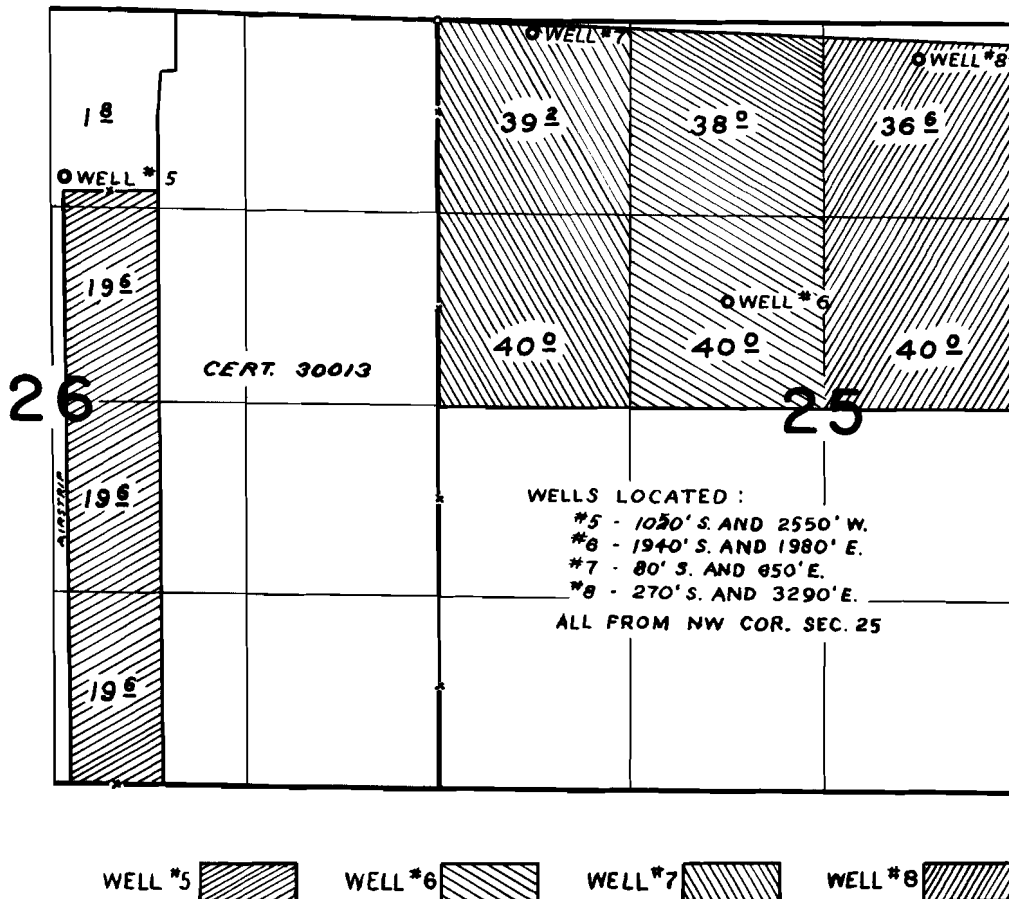

FINAL PROOF SURVEY
UNDER

Application No. G-1964 Permit No. G-1804
IN NAME OF

DERRILL D. MORGER

Surveyed Oct 12 1965, by C. GARDNER