


T.6 S.R.2 W.W.M.

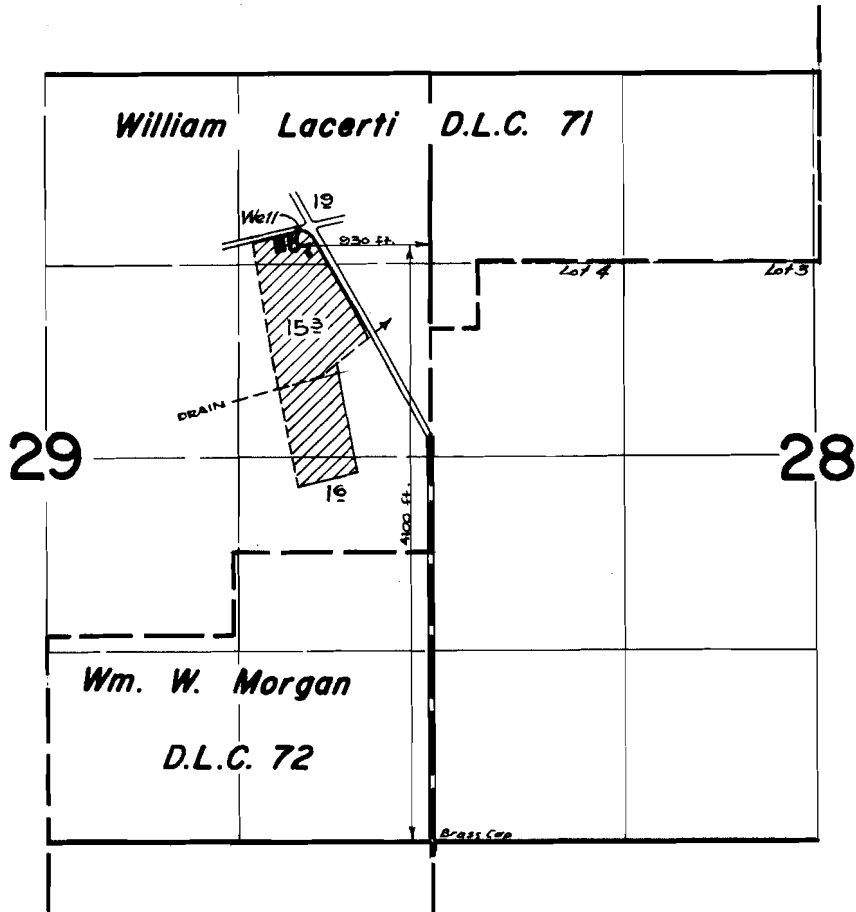

FINAL PROOF SURVEY
UNDER

Application No. G-2817... Permit No. G-2645.
IN NAME OF

RALPH LEA

Surveyed June 16, 1965, by *[Signature]*