


T. 7 S. R. 2 W. W. M.

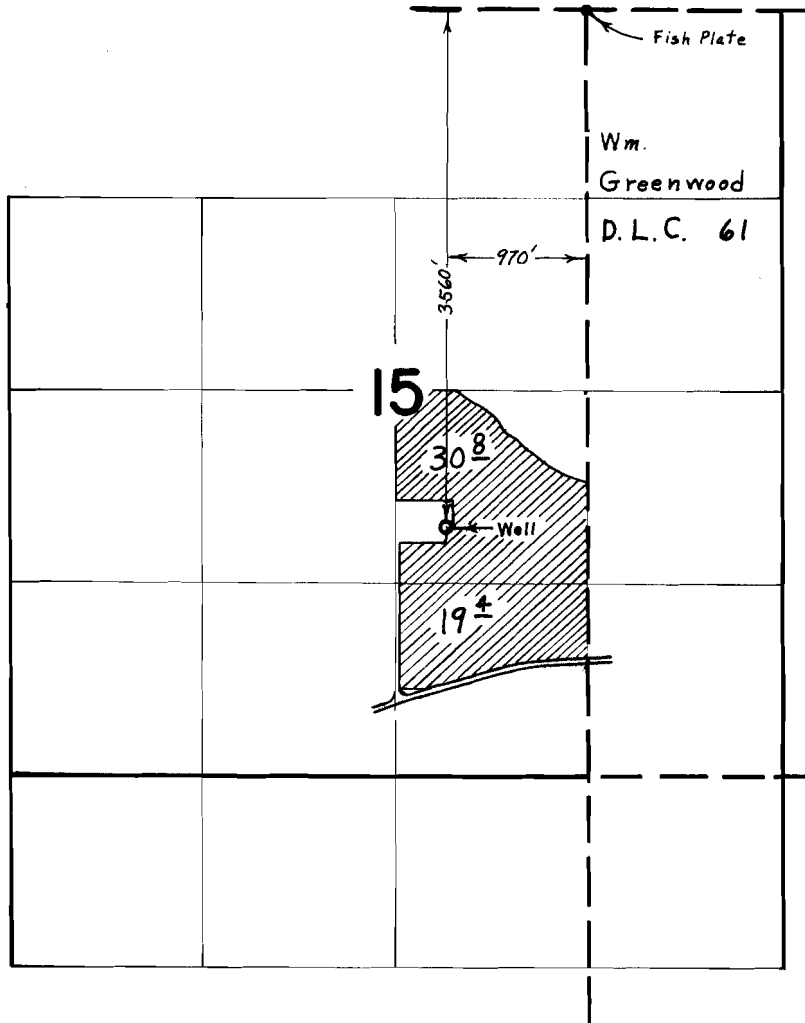

FINAL PROOF SURVEY
UNDER

Application No. G-2860 Permit No. G-2661
IN NAME OF
A. M. LIEN

Surveyed Aug. 16, 1966, by L. E. Gould