


T.8S.R.1W.W.M.

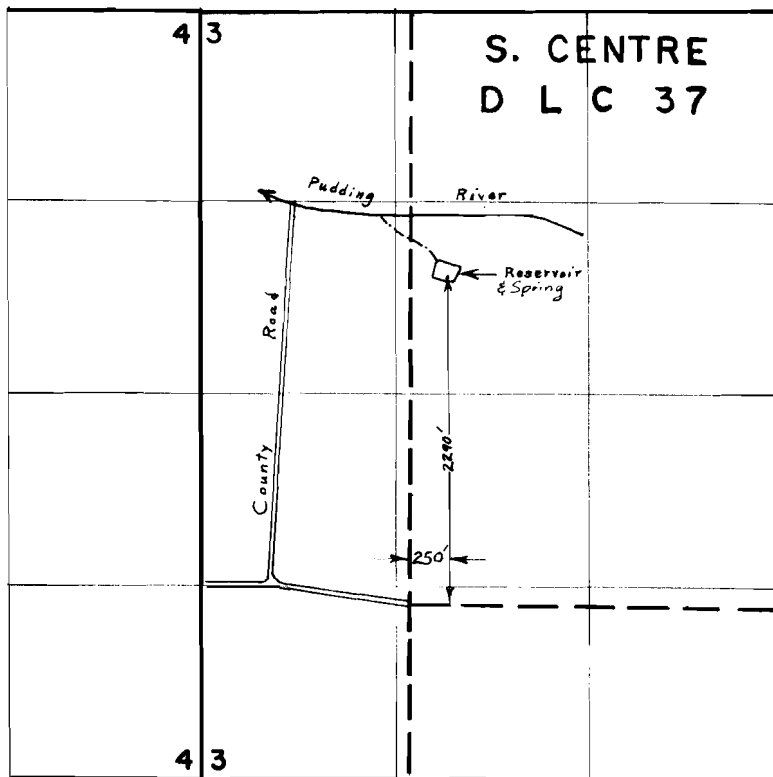

FINAL PROOF SURVEY
UNDER

R-40446 R-4518
Application No. ~~40447~~ Permit No. ~~30150~~
IN NAME OF

BYRON McELHANEY

Surveyed April 26, 1966, by *L. E. Gould*