


T. 7 S. R. 1 W. W. M.

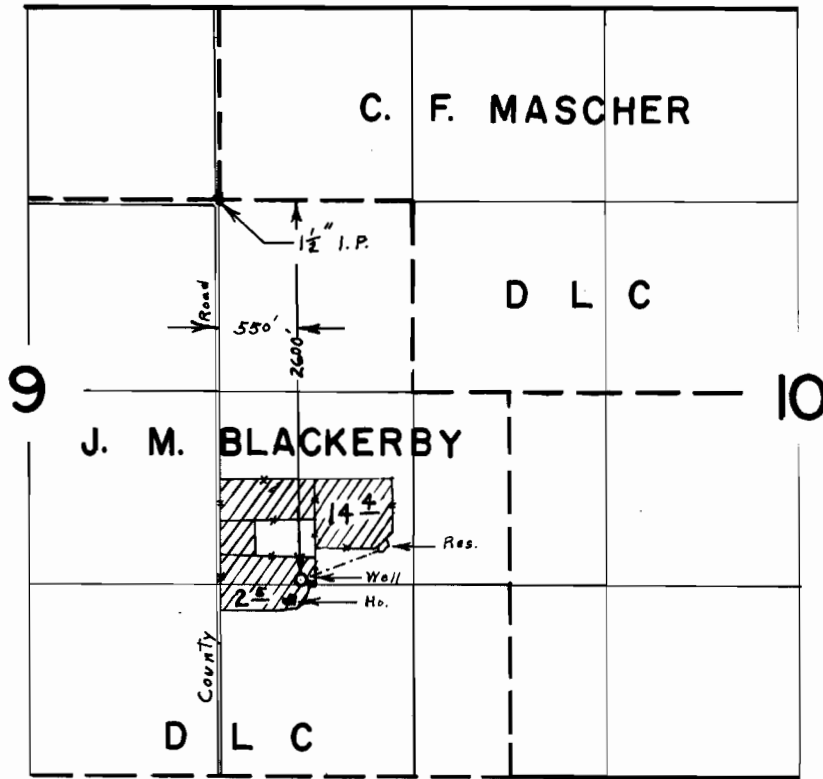

FINAL PROOF SURVEY
UNDER

Application No. G-2661 Permit No. G-2467
IN NAME OF

WAYNE MOORE

Surveyed Aug. 19 1966, by L. E. Gould