


T.7S.R.2W.W.M.

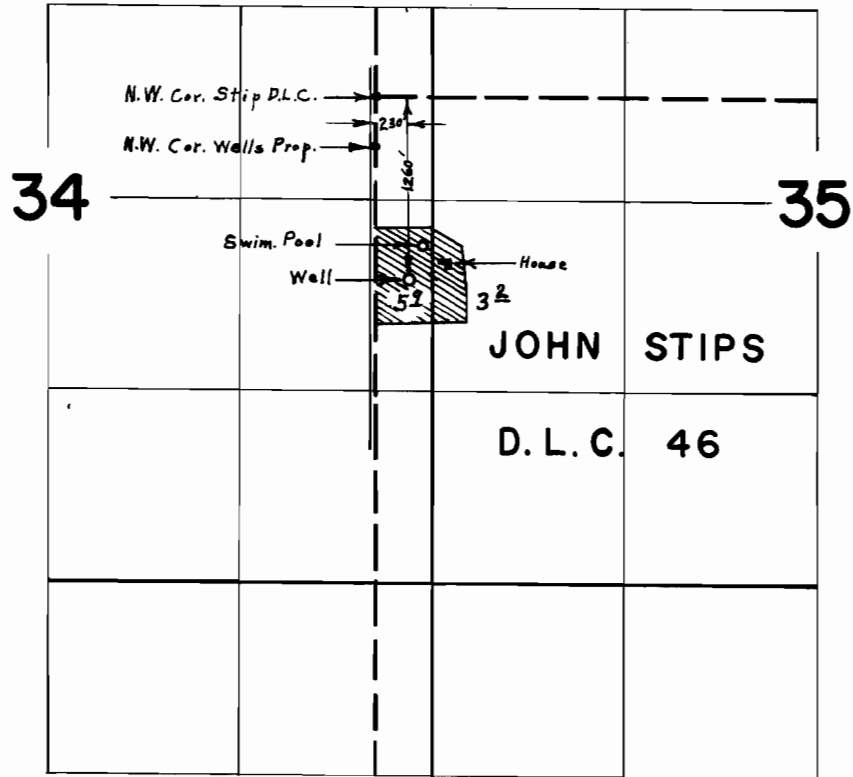

FINAL PROOF SURVEY UNDER

Application No. G-2372 Permit No. G-2185
IN NAME OF

LEE G. WELLS

Surveyed Aug. 17, 1966, by *L. E. Gould*