


# T.2S.R.26E.W.M.

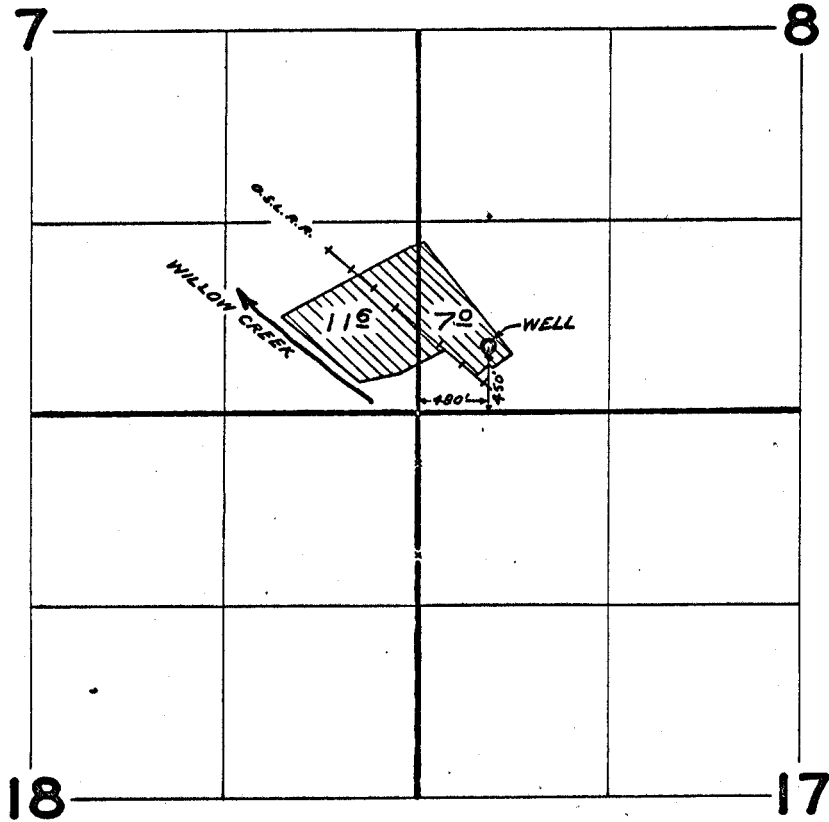

## FINAL PROOF SURVEY UNDER

Application No. G-1829 Permit No. G-1677  
IN NAME OF  
**THE FIRST NATIONAL BANK**  
**OF OREGON, TRUSTEE**

Surveyed JUN. 30, 1966, by L. GOULD