


T.35., R27E.


SEP 10 1951

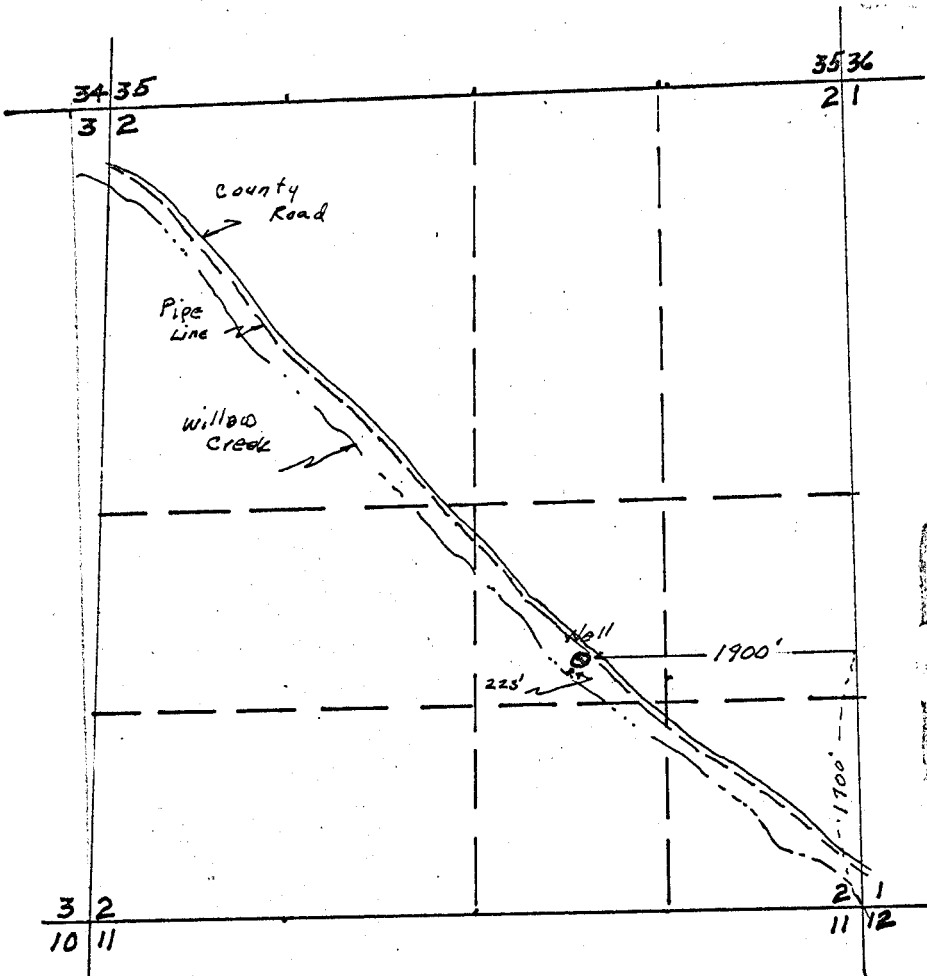

Scale-
4" = 1 mile



I, J. C. Payne, certify
this map was prepared
from field location &
Aerial map.

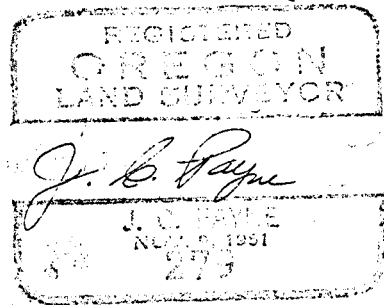

Well Location
for
City of Heppner.

Application No. D-2454
Permit No. G-2271

34278
9-2271