


T.5 N. R. 27 E. W.M.

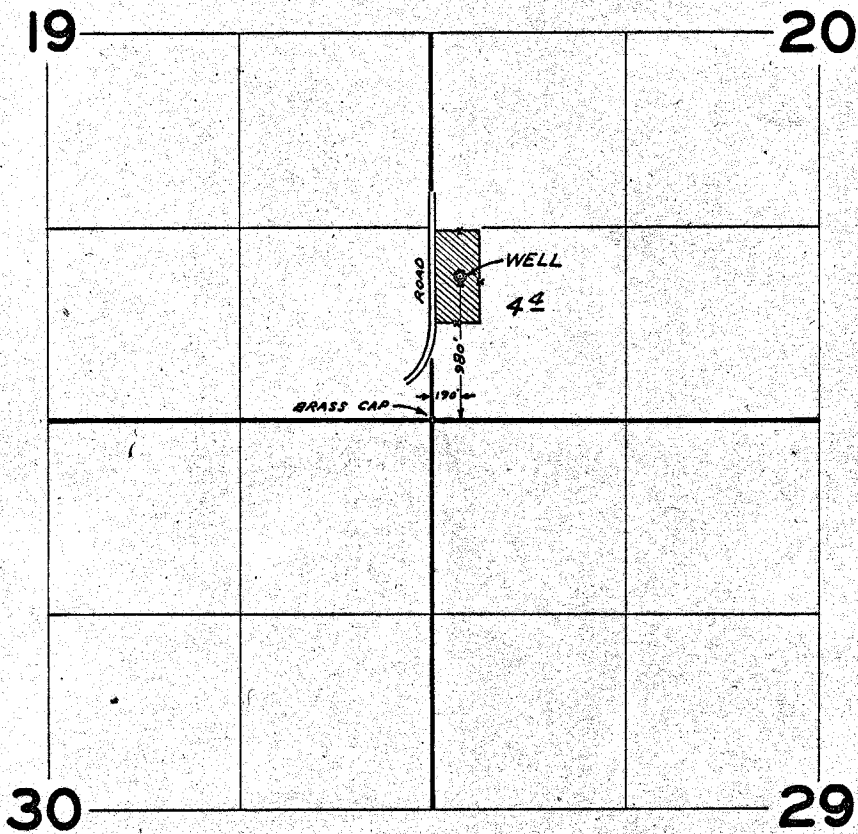

FINAL PROOF SURVEY UNDER

Application No. G-2149 Permit No. G-1982
IN NAME OF

IRRIGON CEMETARY MAINTENANCE DISTRICT

Surveyed JUN. 22, 1966, by L. GOULD