


G-1965
34280

Section 8 Township 3N

Range 27E 6W Meridian

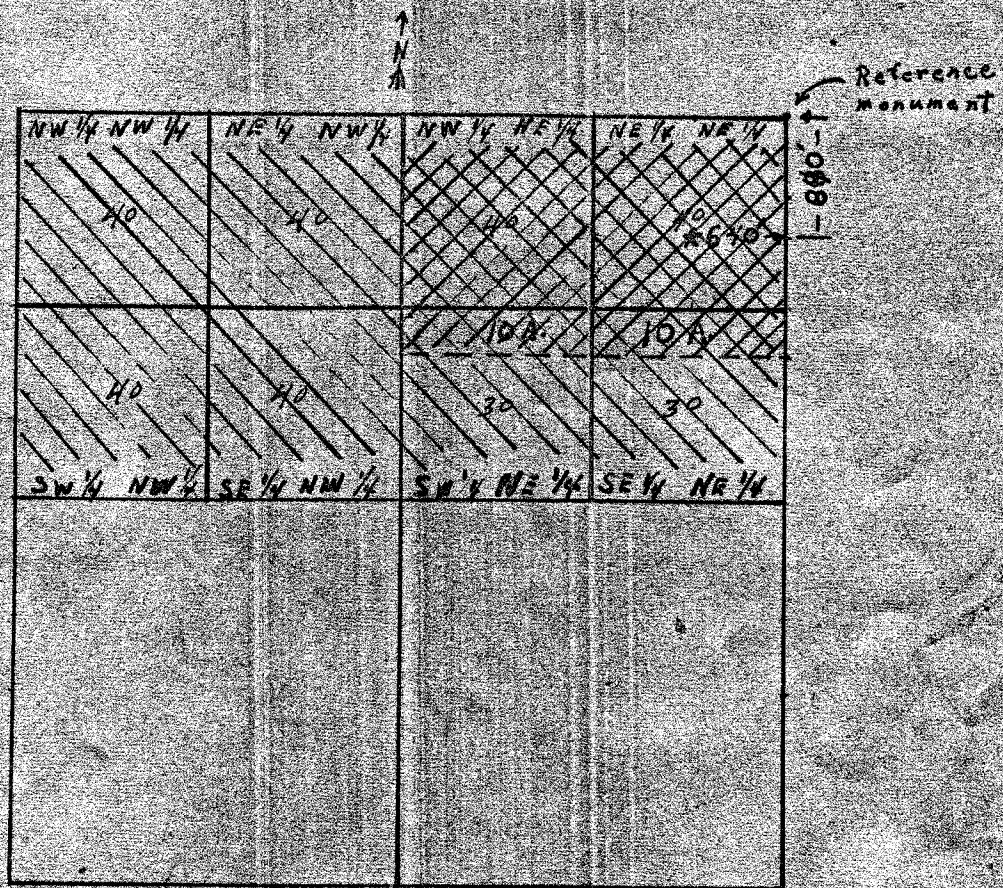

Scale: 1 Inch = 1 Mile

- * Well location
- /// Proposed Irrigated area
- XXXX Irrigated Area

Application No. G-2125
Permit No. G-1965