


T. 1 N. R. 27 E. W. M.

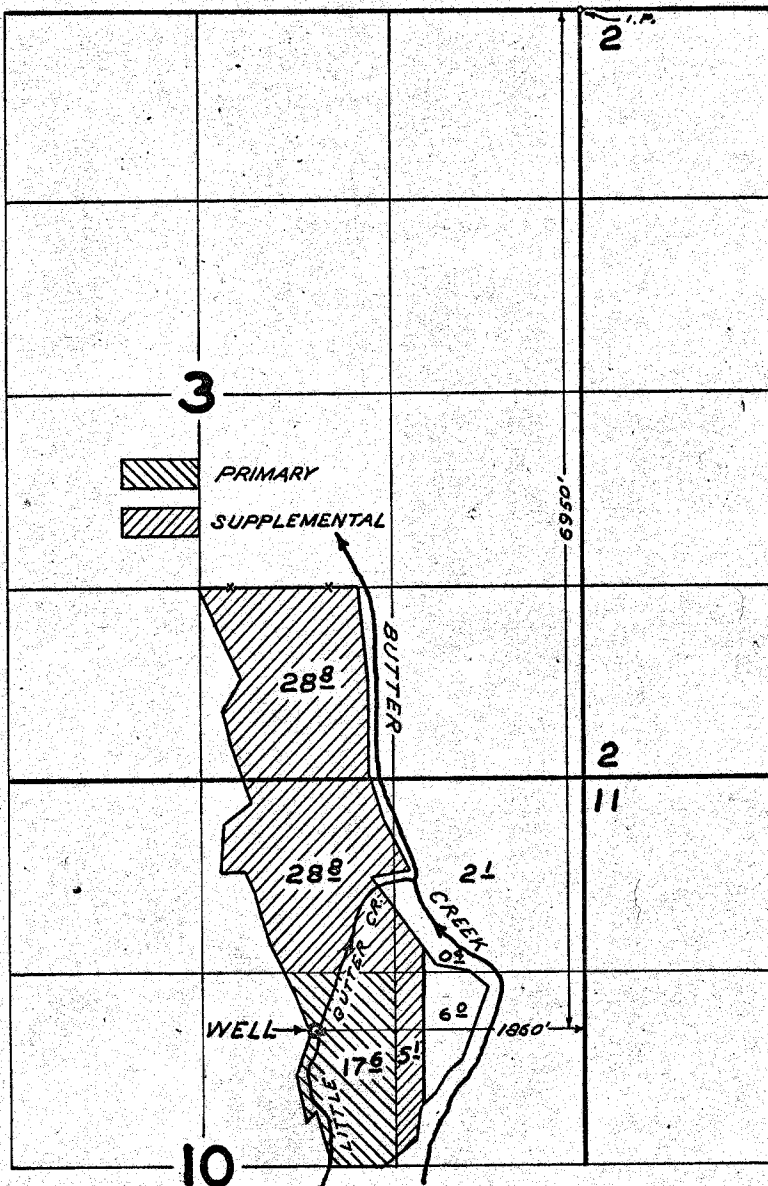

FINAL PROOF SURVEY UNDER

Application No. G-2226 Permit No. G-2047
IN NAME OF

EARL W. WATTENBURGER

Surveyed JUN. 25. 1966, by L. GOULD