


7 G-2528
34284

T. 1 & 2 N. R. 27 E. W. M.

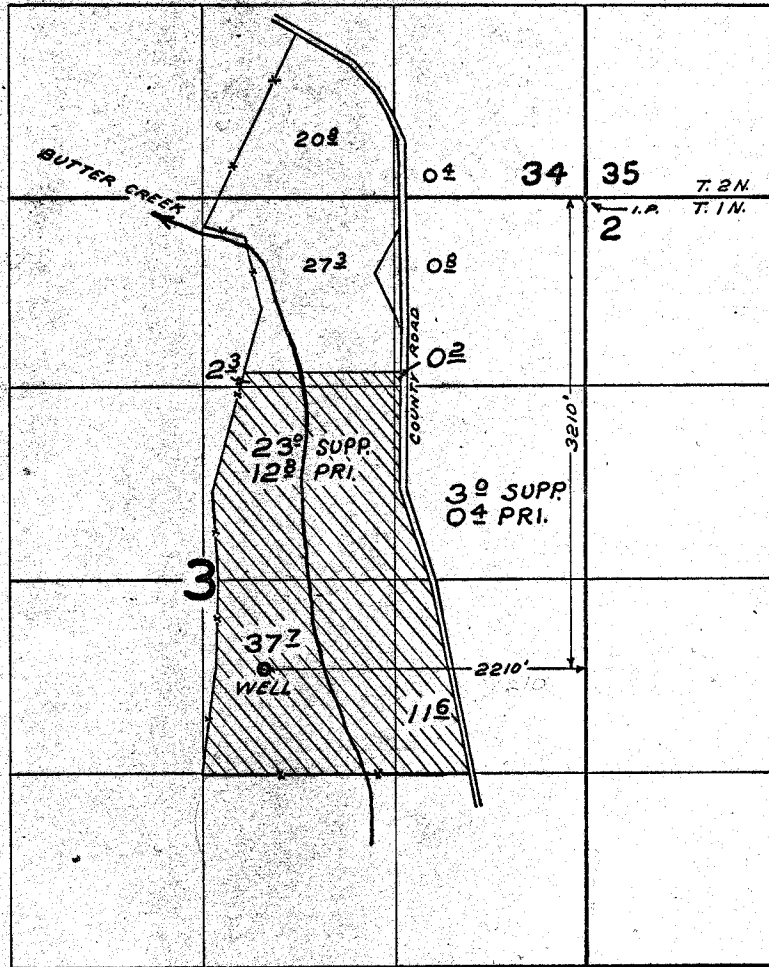

FINAL PROOF SURVEY UNDER

Application No. G-2730 Permit No. G-2528
IN NAME OF

EDWARD B. WATTENBURGER

Surveyed JUN. 24 1966, by L. GOULD