


T.9S. R.6W. W.M.

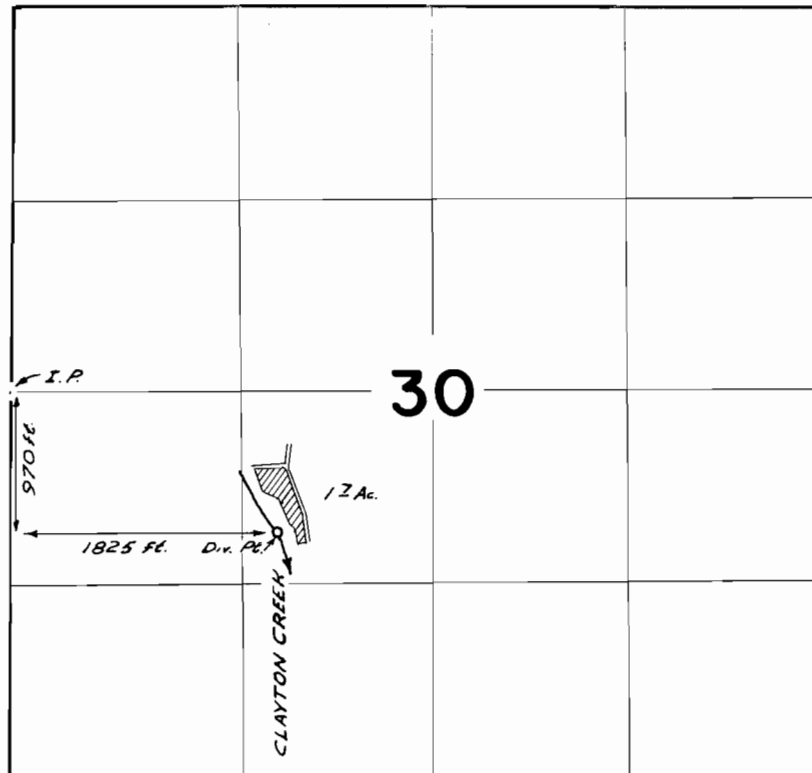

FINAL PROOF SURVEY UNDER

Application No. 37805 Permit No. 28197
IN NAME OF

N. L. VAN KLEECK

Surveyed July 27 1966, by W.J. Ruppert