


T.7S. R. 4 W.W.M.

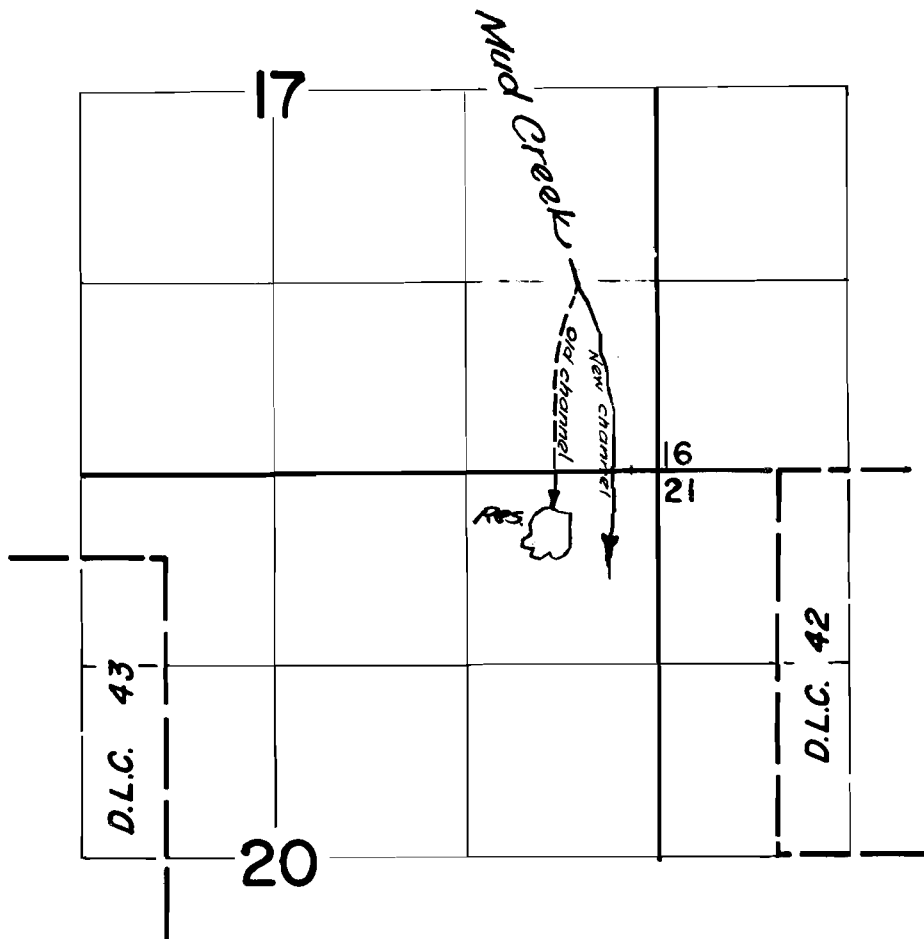

FINAL PROOF SURVEY
UNDER

Application No. R-38200 Permit No. R-3165
IN NAME OF

PARK ACRES COMPANY

Surveyed June 3 1966 by *R. Jackson*