


T.5S.R.5W.W.M.

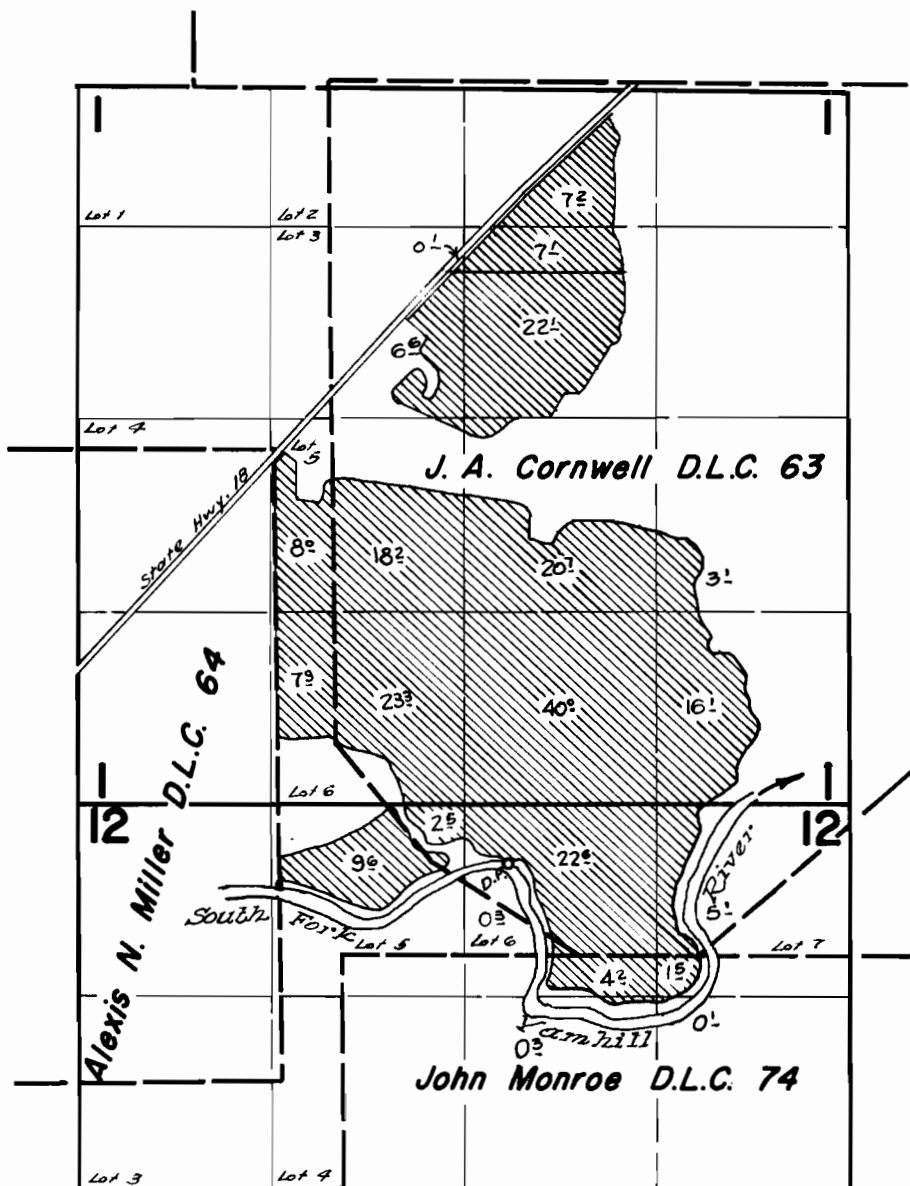

Dir. Pt. is located 2840 Ft. South & 1570 Ft. East from N.E. Cor. D.L.C. 64

FINAL PROOF SURVEY UNDER

Application No. **34661** Permit No. **27225**
IN NAME OF

MARVIN BERNARDS

Surveyed August 5 1965, by *R. Jackson*