


28553  
34290

# T.34S. R.7E. W.M.


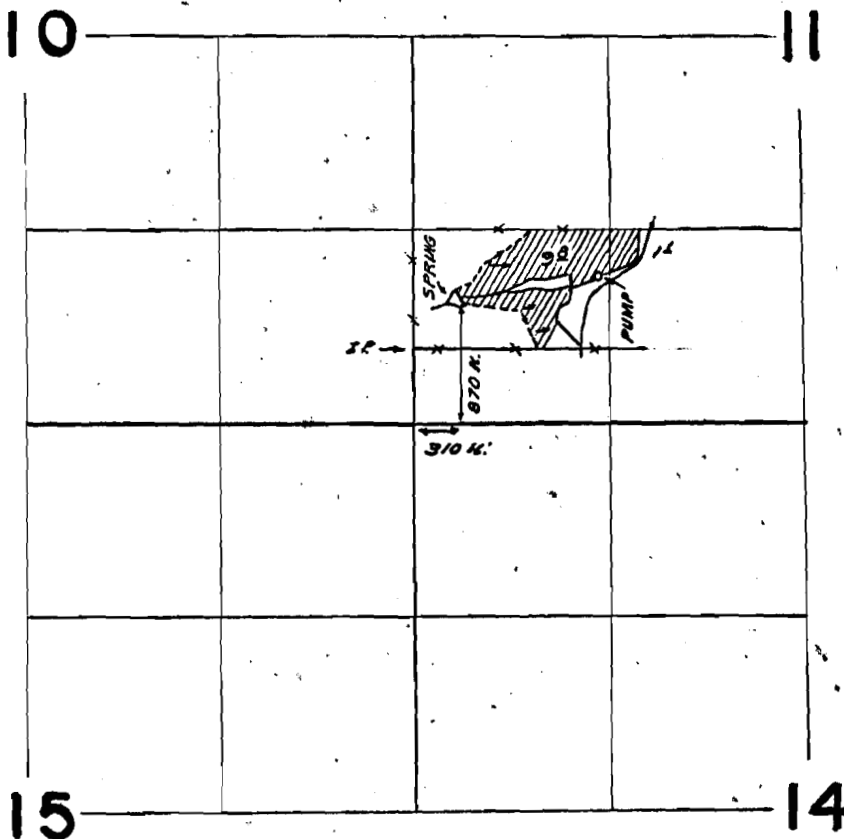

## FINAL PROOF SURVEY UNDER

Application No. 37938 Permit No. 28553  
IN NAME OF

Bob Farris

Surveyed Oct. 7, 1966, by N.J. Ruppert