


# T.2S.R.39E.W.M.

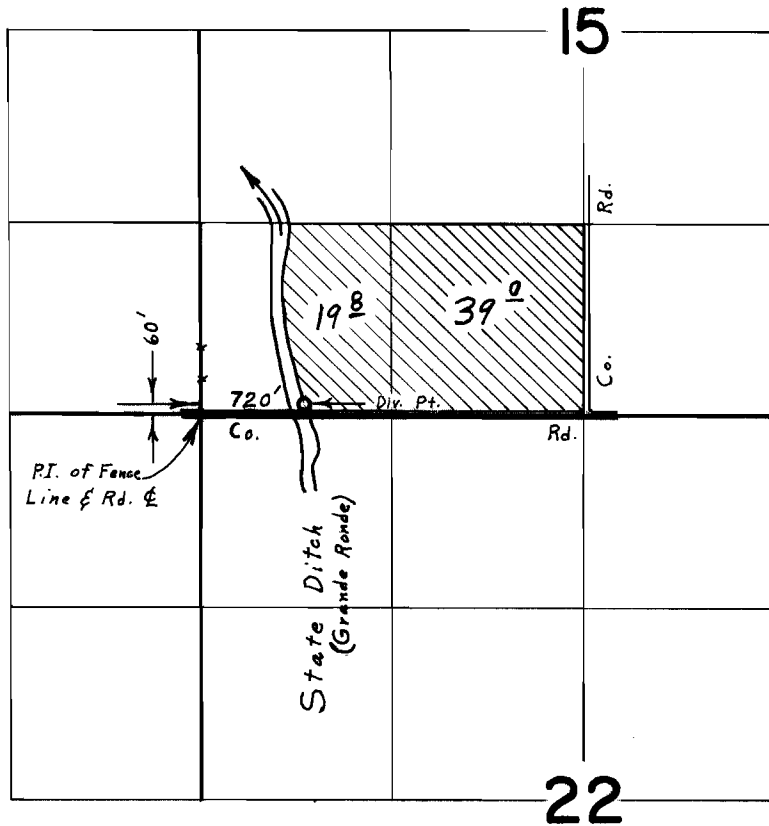

## FINAL PROOF SURVEY UNDER

Application No. 38556 Permit No. 28686  
IN NAME OF

CRESTON J. SHAW

Surveyed Nov. 2, 1966, by L. E. Gould