


T.4S.R.5W.W.M.

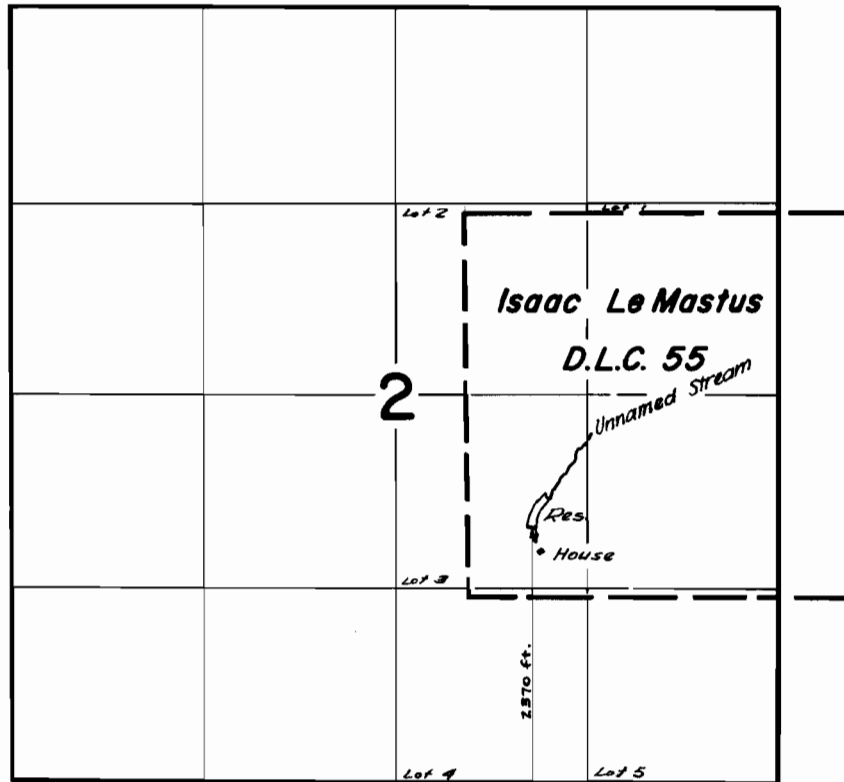

**FINAL PROOF SURVEY**  
UNDER

R-38989                      R-3690  
Application No. 38990    Permit No. 29047  
IN NAME OF

MARTIN H. GASS

Surveyed August 5, 1965, by M. H. Jackson