


T.4S.R.5W.W.M.

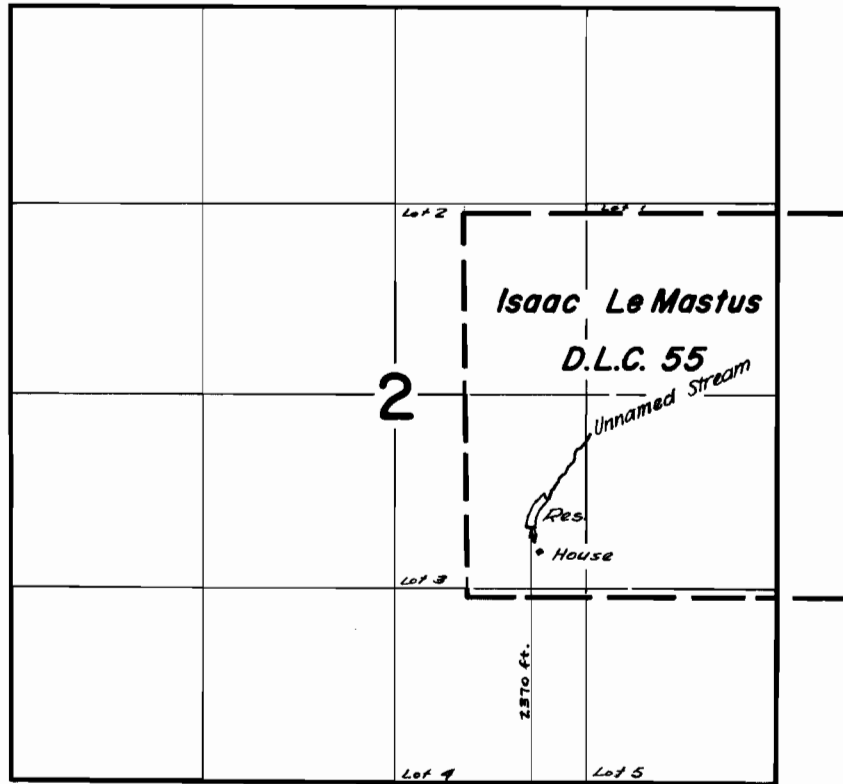

D.L.C. 42

FINAL PROOF SURVEY
UNDER

R-38989 R-3690
Application No. ~~38990~~ Permit No. 29047
IN NAME OF

MARTIN H. GASS

Surveyed August 5, 1965, by *A.H. Jackson*