


T.36S.R.3W.W.M.

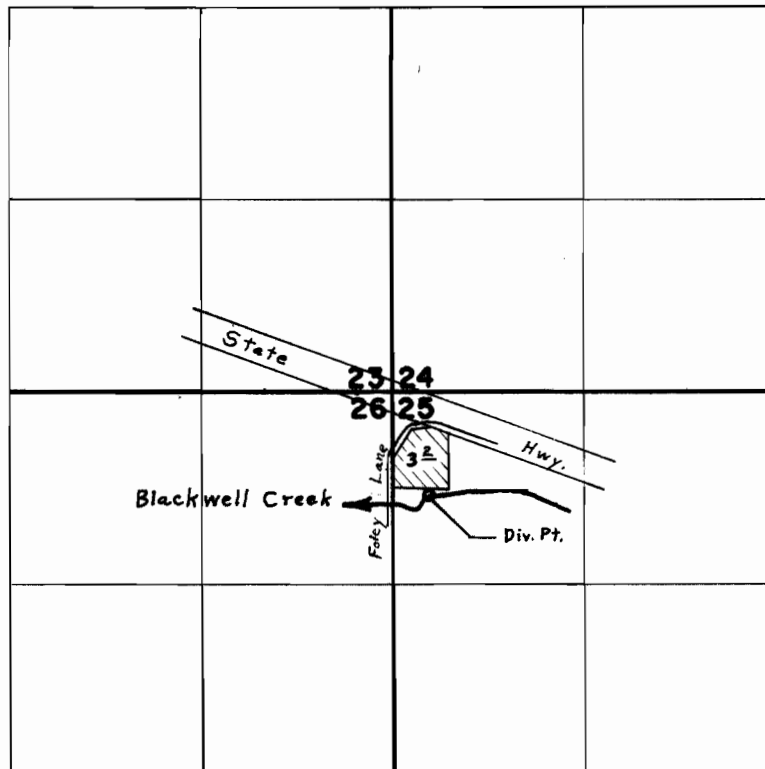

Div. Pt. Located 250' E. & 720' S. From N.W. Cor. Sec. 25

FINAL PROOF SURVEY
UNDER

Application No. 37438 Permit No. 27876

IN NAME OF

JAMES W. LEHRMAN &

THE ESTATE OF JOHN F. DUNN

Surveyed June 1, 1966, by L. E. Gould