


T.32S.R.3E.W.M.

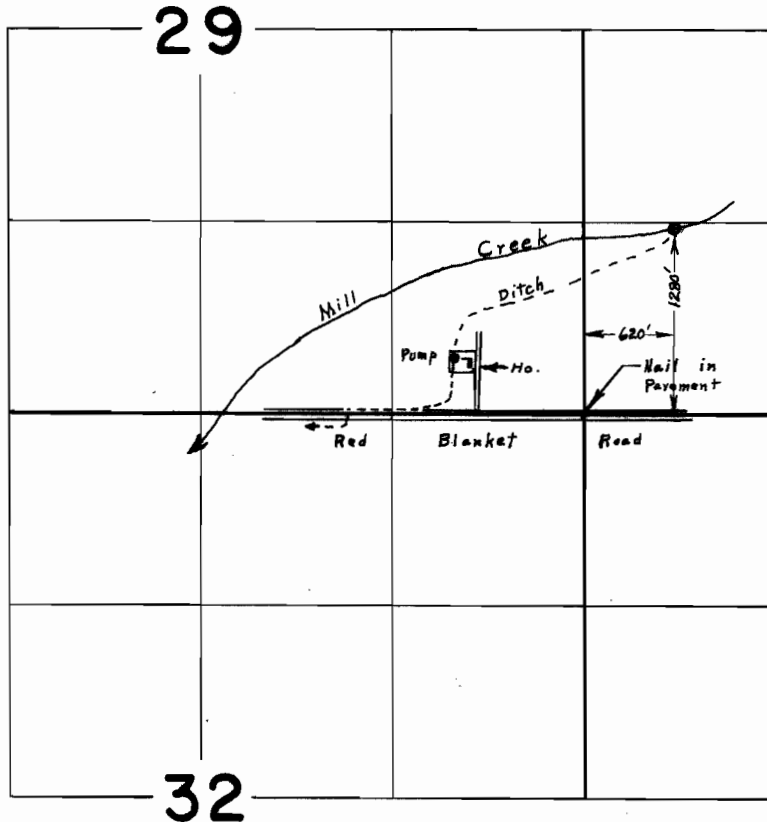

**FINAL PROOF SURVEY**  
UNDER

Application No. 38251 Permit No. 28492  
IN NAME OF

RICHARD L. & NORMA J. MAST

Surveyed July 21, 1966, by L. E. Gould