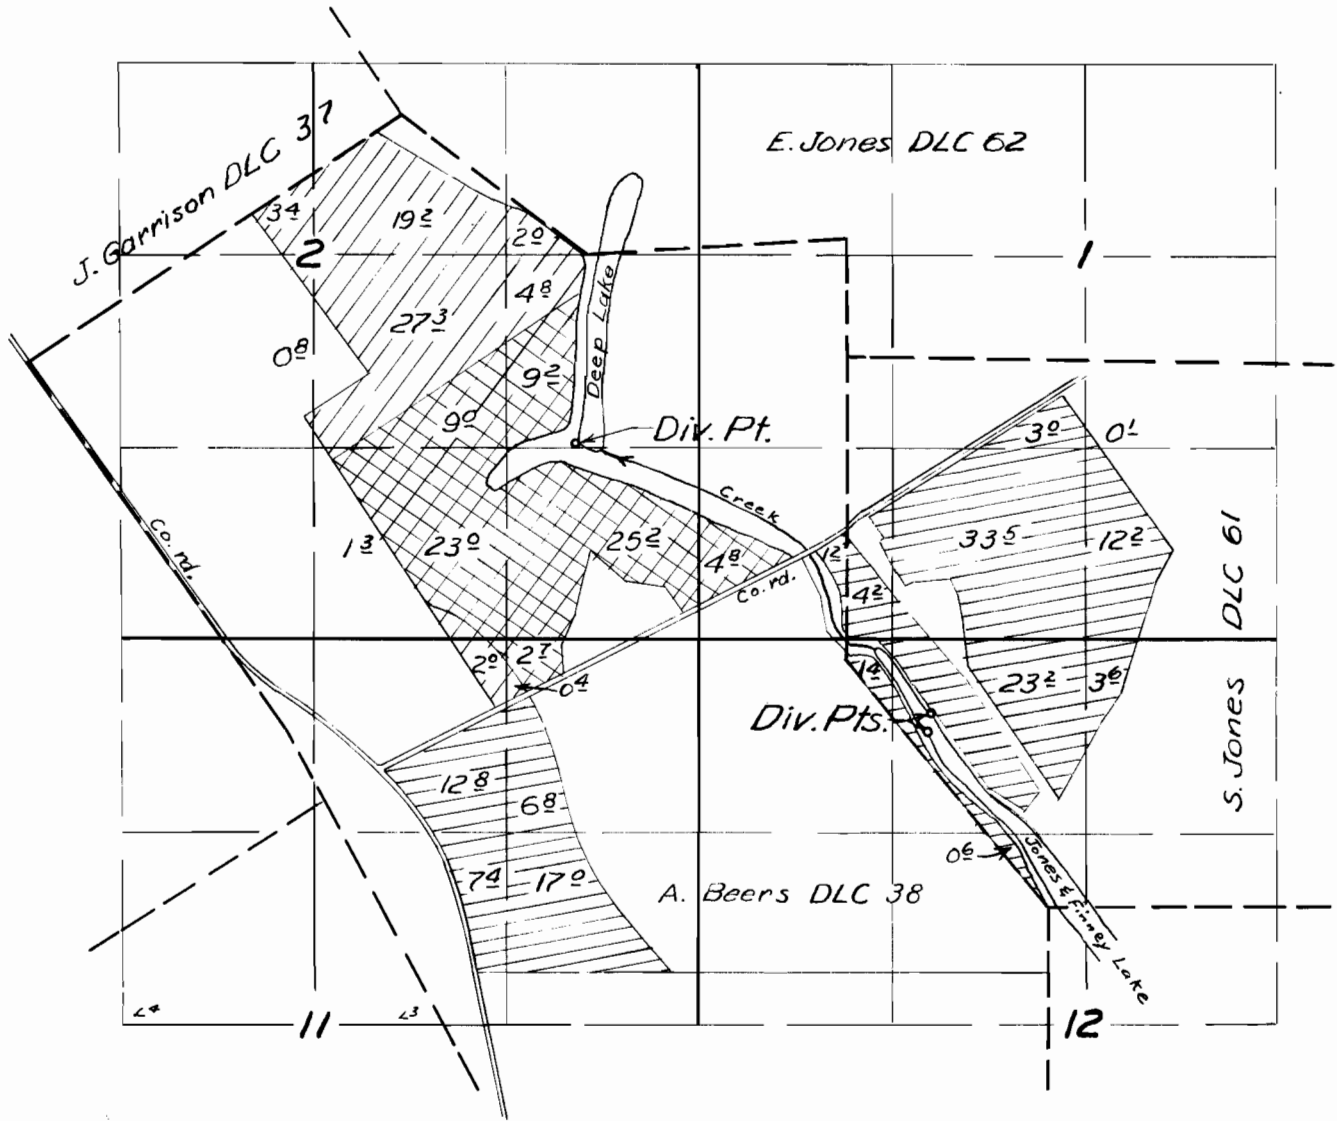


T. 6 S.R.3 W.W. M.


 



**FINAL PROOF SURVEY**  
UNDER

Application No. 28286 Permit No. 22354.  
IN NAME OF

*Creighton B. Jones*

Surveyed 5 Sept. 1956, by *Tom Bick*

From Deep Lake Prim.  Supp   
From Jones & Finney Lake 

1956 K  
DFN-3D-50