


T.8S.R.46 E.W.M.

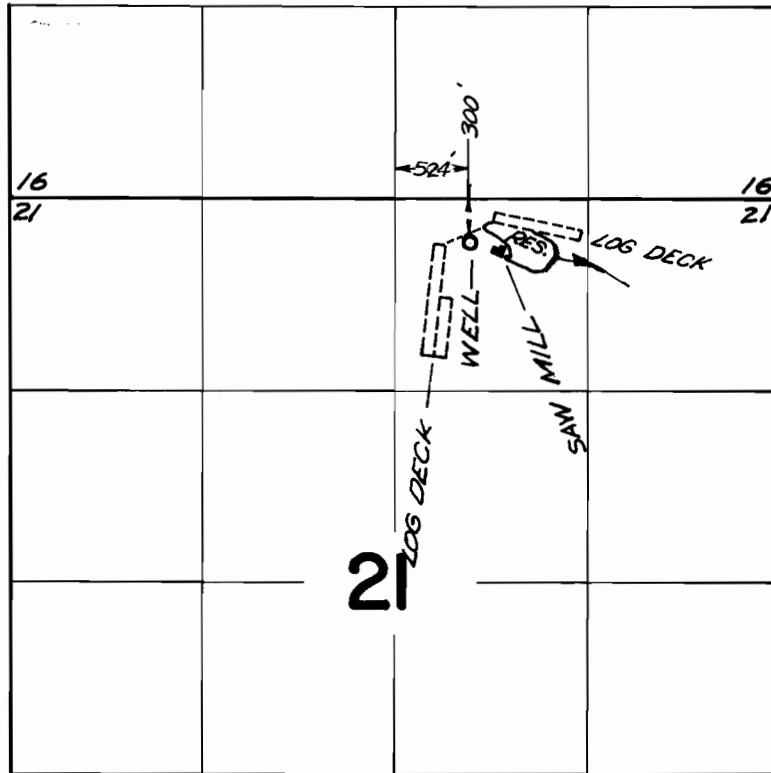

FINAL PROOF SURVEY UNDER

Application No. G.3375 Permit No. G.3010
IN NAME OF

ELLINGSON LUMBER CO.

Surveyed Aug. 10, 1966, by V. GARNER