
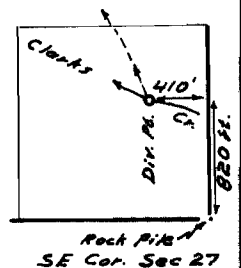


T.12 S. R. 41 E. W.M.

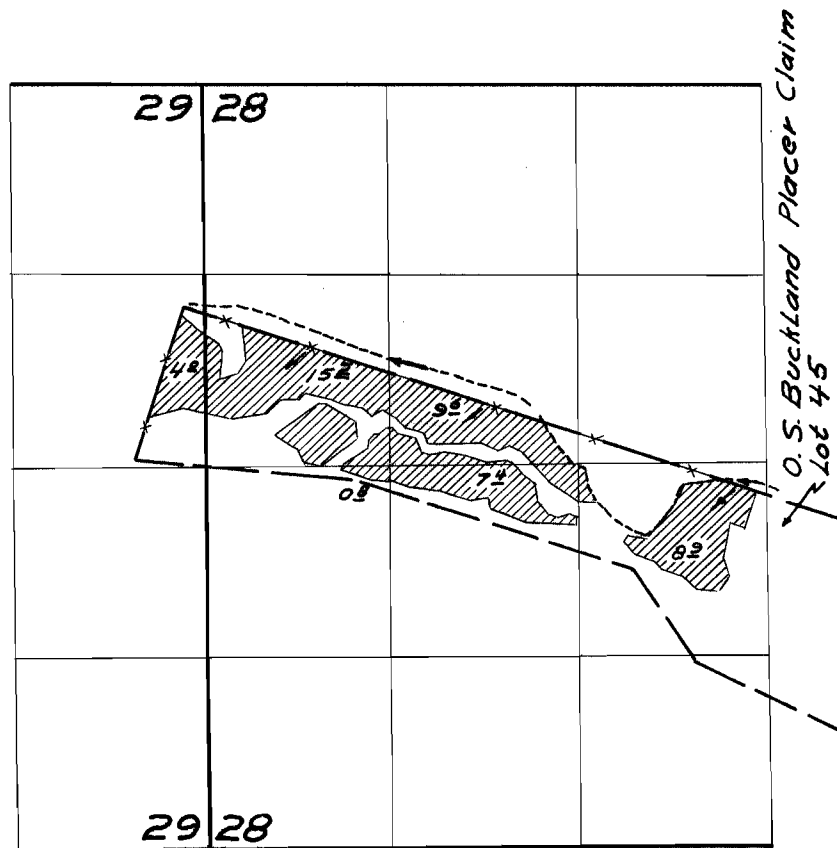

FINAL PROOF SURVEY
UNDER

Application No. 37592 Permit No. 28007
IN NAME OF

Harry Elliott

Surveyed Aug. 4, 1966, by W. J. Ruppert