


T.7&8 S. R.45 & 46 E. W.M.

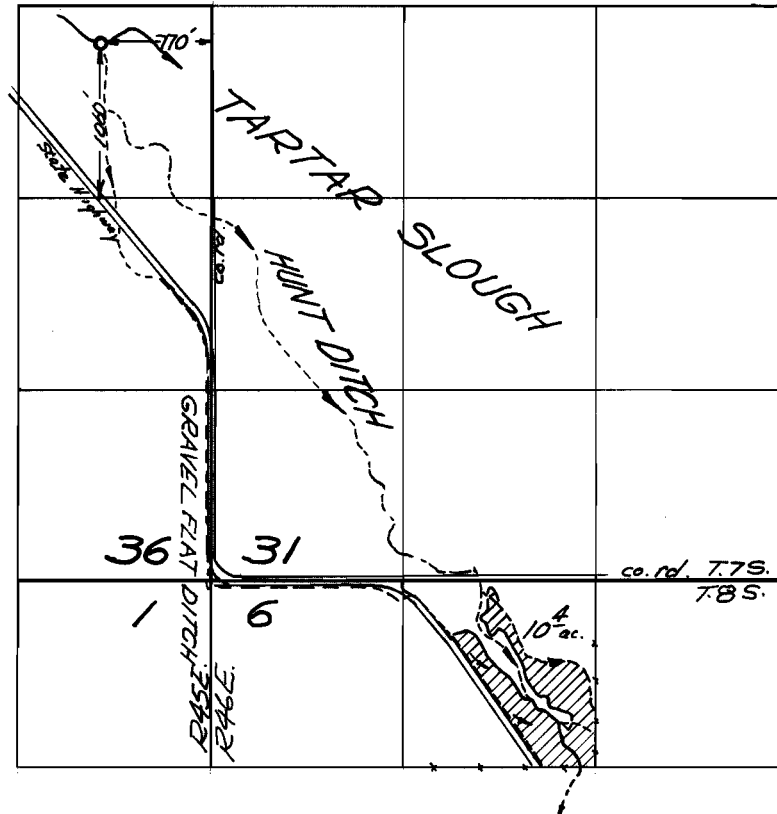

FINAL PROOF SURVEY UNDER

Application No. 40972 Permit No. 30554
IN NAME OF

RALPH GAGE

Surveyed Aug. 10, 1966, by V. GARNER