


T. 8 S. R. 46 E. W. M.

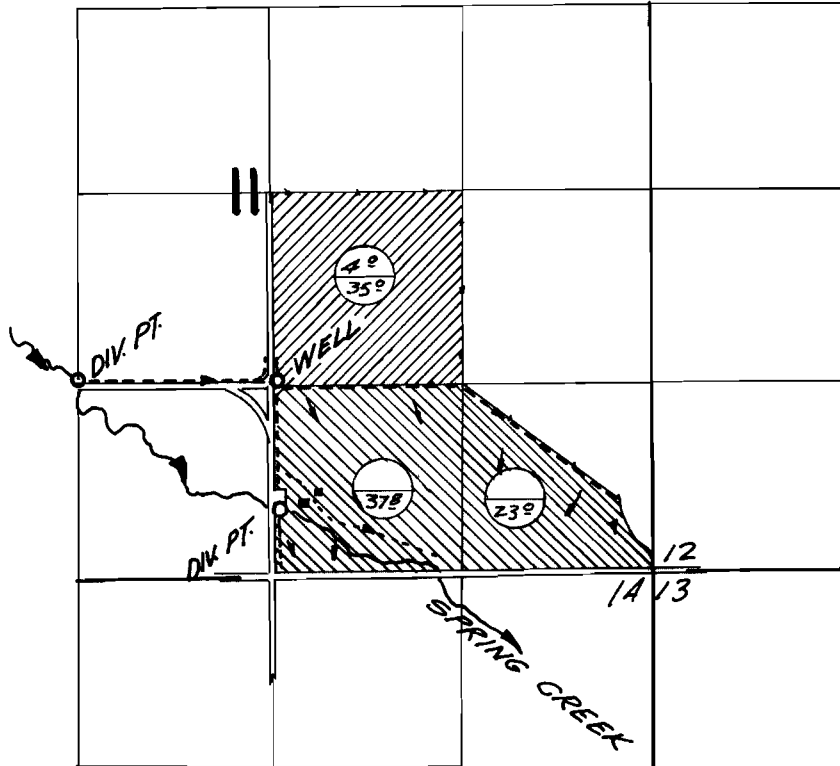

Well located 52 ft east & 29 ft North from the SW cor. NW $\frac{1}{4}$ SE $\frac{1}{4}$ Sec. 11 DIV. PTS. Located 30 ft. N. & 1315 ft W; 870 ft. S. & 30 ft. E. from the SW cor. NW $\frac{1}{4}$ SE $\frac{1}{4}$ of Section 11

○ Supplemental
 ◓ Primary

FINAL PROOF SURVEY UNDER

G 2179 G-2009 
 Application No. 40713... Permit No. 30327 
 IN NAME OF

GOVER and BARTON

Surveyed Aug. 6, 1966, by V. GARNER.