


T.8S.R.46 E. W.M.

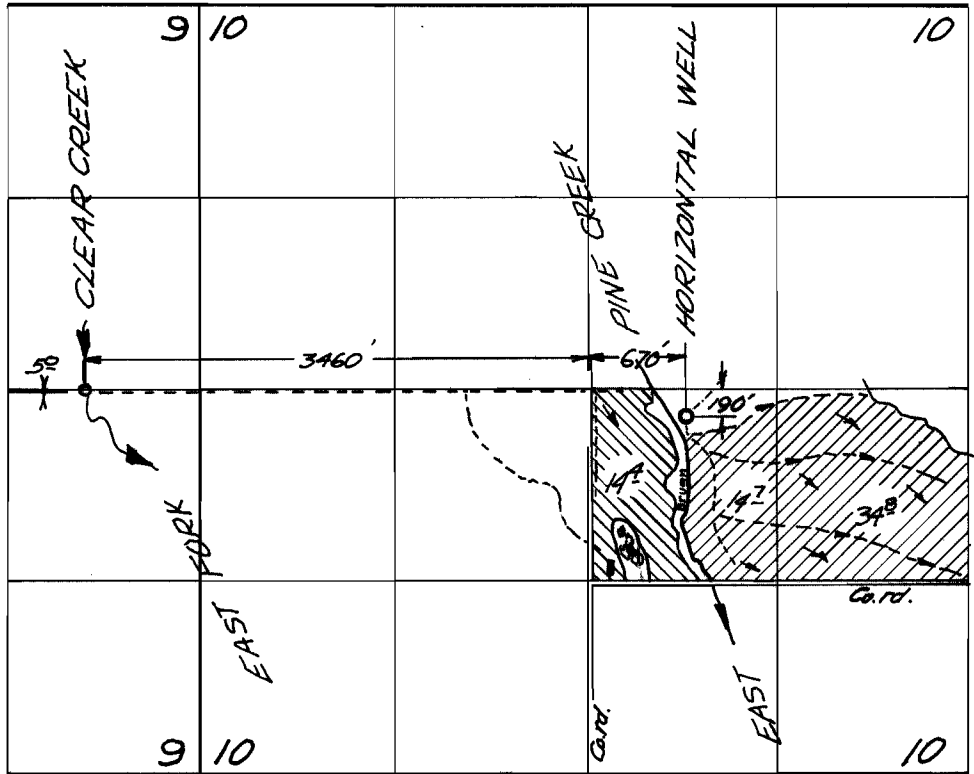

FINAL PROOF SURVEY UNDER

G 2410 G 2217
 Application No. 39520. Permit No. 29404
 IN NAME OF

WALTER R. IRWIN

Surveyed Aug. 6, 1966 by V. GARNER