


T. 8 S. R. 45 E. W.M.

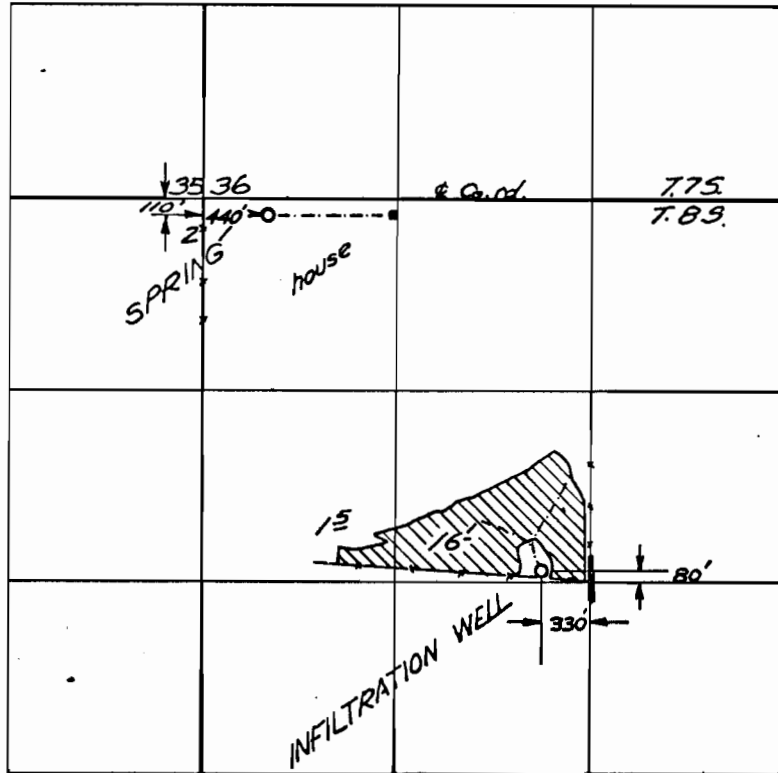

FINAL PROOF SURVEY UNDER

G-2776 G 2575
Application No. 41178... Permit No. 30694
IN NAME OF

GEORGE LANGLEY

Surveyed Aug. 8, 1966, by V. SARNER...