


T. 8S. R. 40E. W. M.

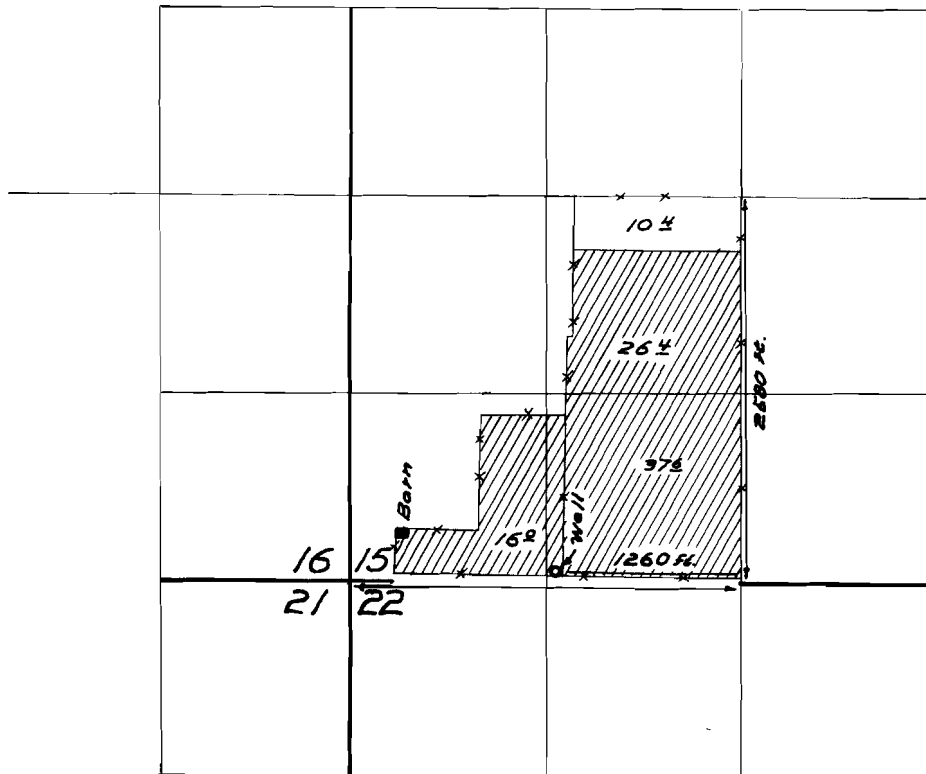

FINAL PROOF SURVEY
UNDER

Application No. G-2772 Permit No. G-2572
IN NAME OF

F. S. Mack

Surveyed Aug 10 1965, by W. J. Ruppert