


T. 8S. R. 39E. W.M.

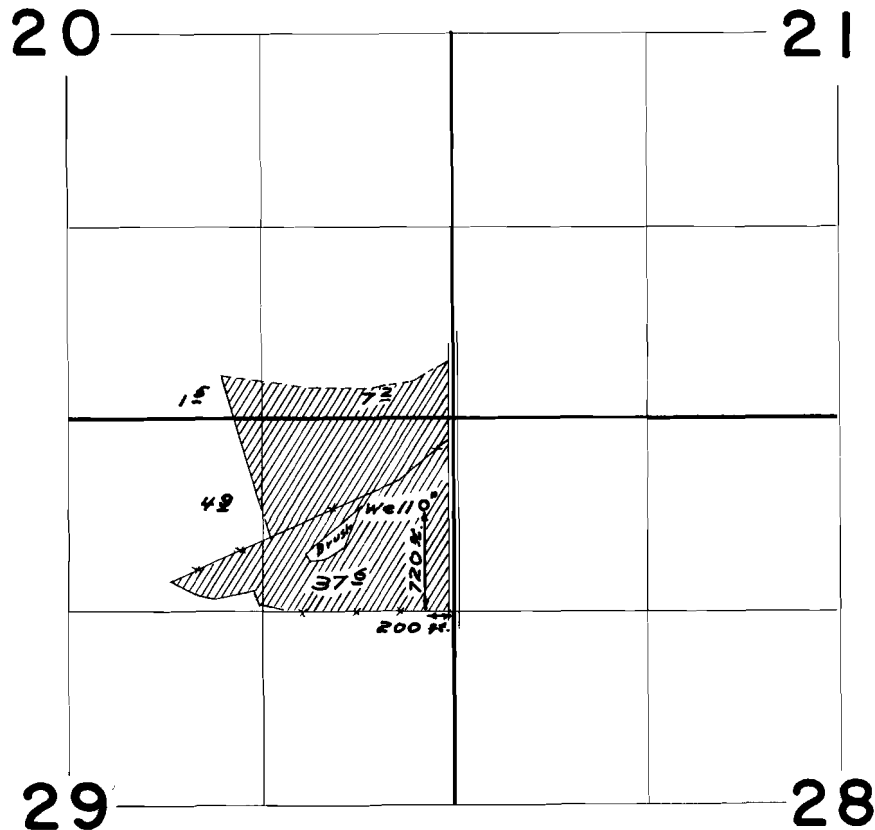

FINAL PROOF SURVEY
UNDER

Application No. G-2985 Permit No. G-2768
IN NAME OF

A.F. Moser

Surveyed Aug 9 1956 by W. J. Ruppert