


T.8 S. R.45 & 46 E. W.M.

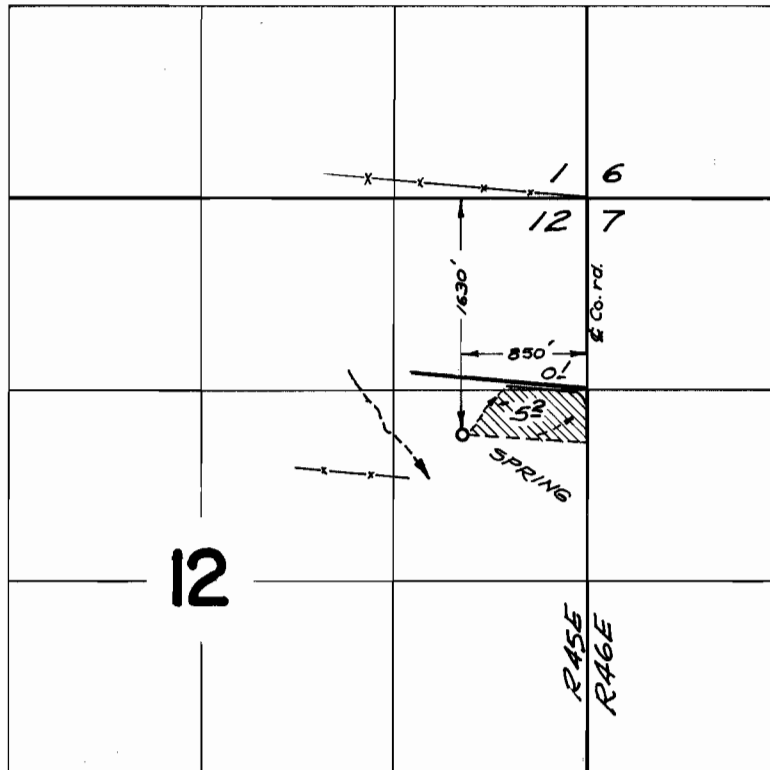

FINAL PROOF SURVEY UNDER

Application No. 41020 Permit No. 30583
IN NAME OF

JOSEPH PINAIRE

Surveyed Aug. 8, 1966, by V. GARNER