


# T. 8 S. R. 45 & 46 E. W.M.

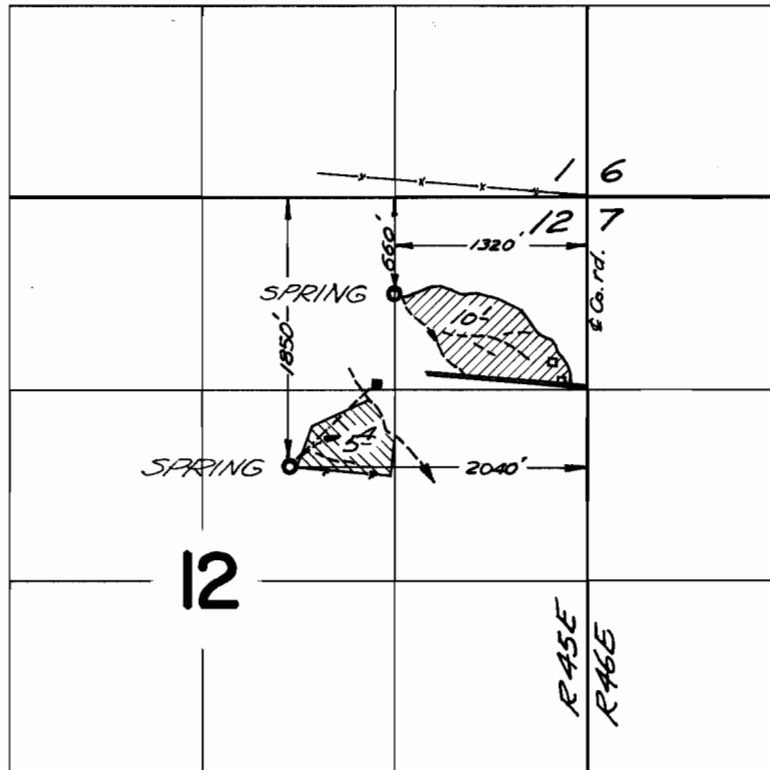

## FINAL PROOF SURVEY UNDER

Application No. 41021 Permit No. 30584  
IN NAME OF

LEE THOMPSON

Surveyed Aug. 8, 1966, by V. GARNER