


T. 8 S.  
R. 40 E.  
W. M.

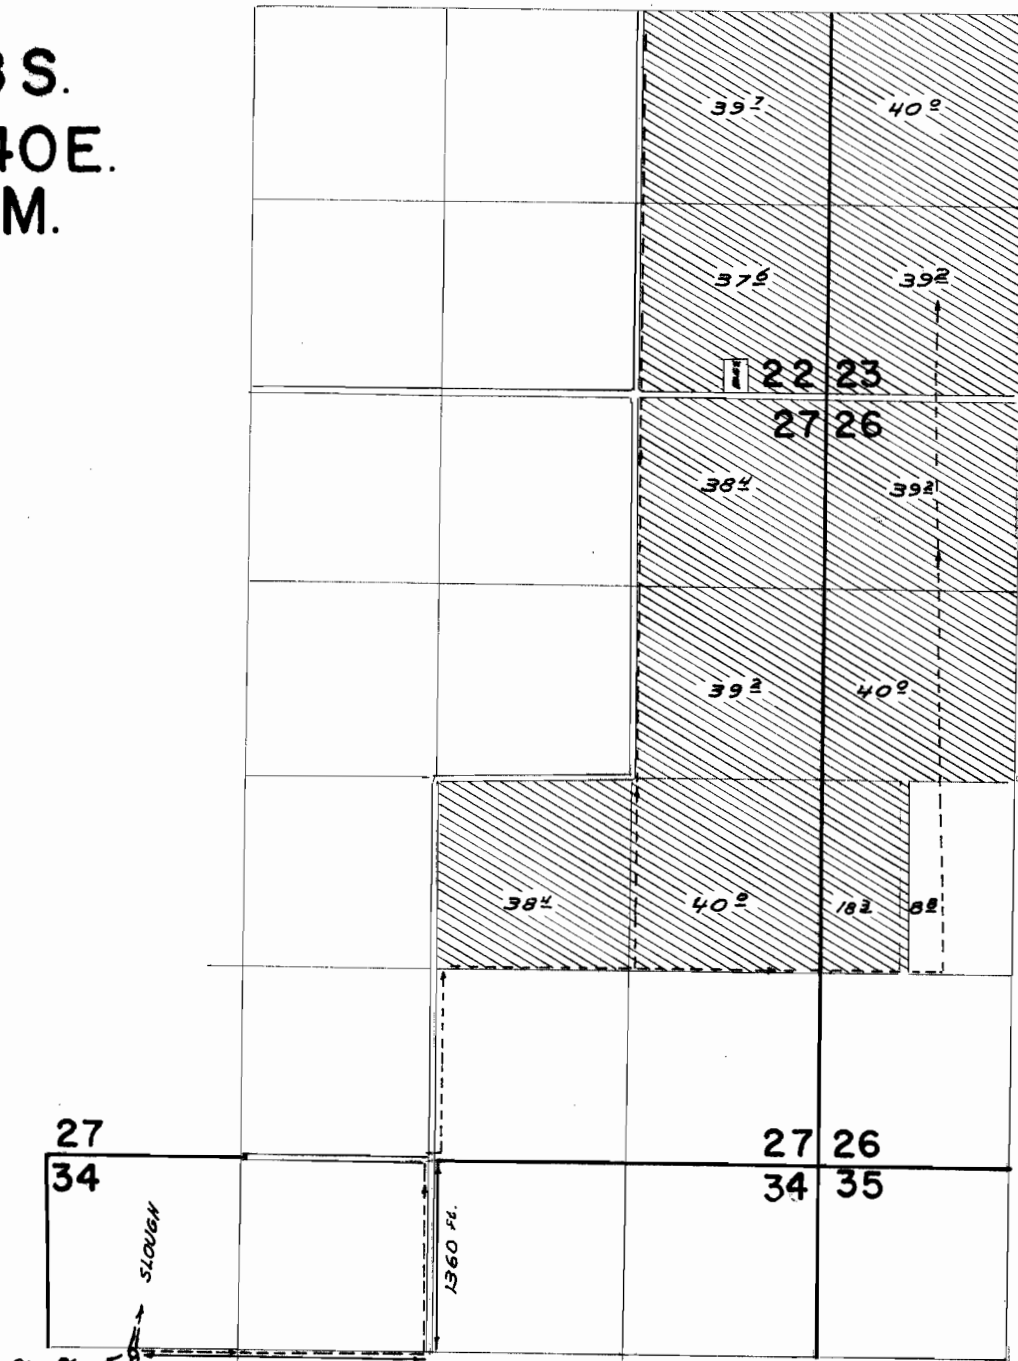

**FINAL PROOF SURVEY**  
UNDER

Application No. 38089 Permit No. 28396  
IN NAME OF

Clyde Ward

Surveyed Aug 10 1966, by W.J. Ruppert