


T.8S. R. 39E.W.M.

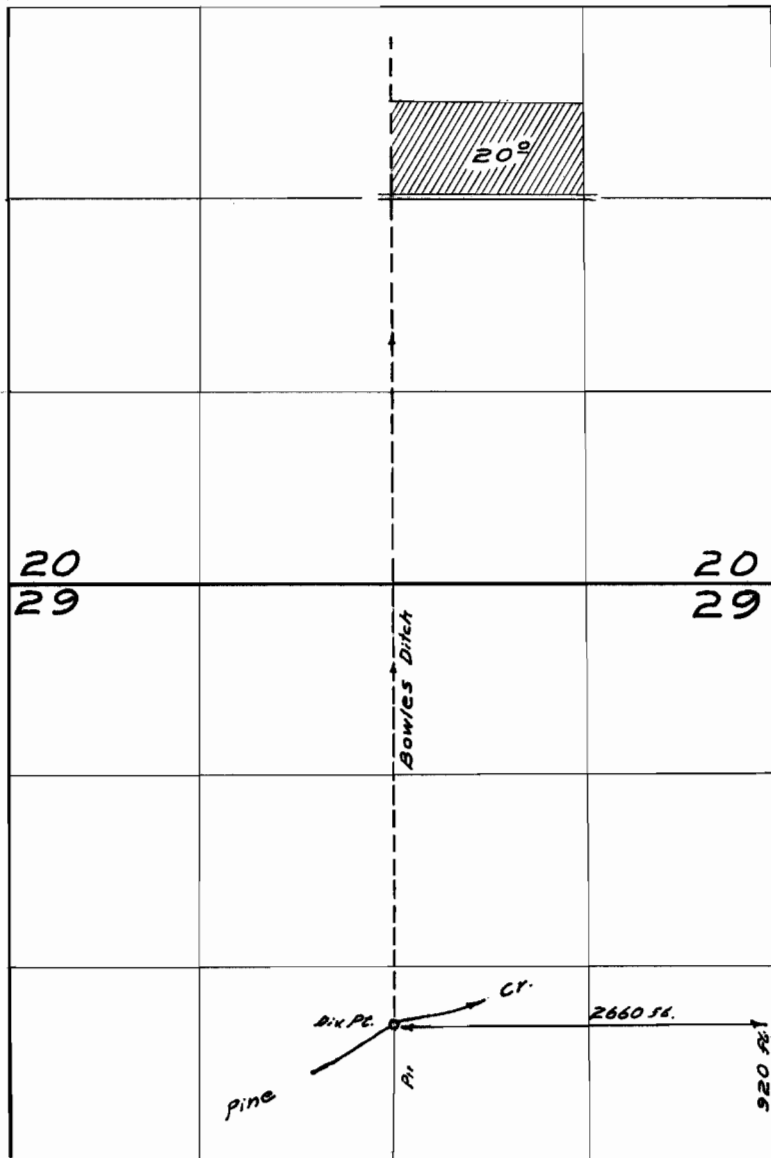

FINAL PROOF SURVEY UNDER

Application No. 37594 Permit No. 28008
IN NAME OF

Fred S. Weishaar

Surveyed Aug 2 1966, by W. J. Ruppert