


T.14 S. R.6 W. W.M.

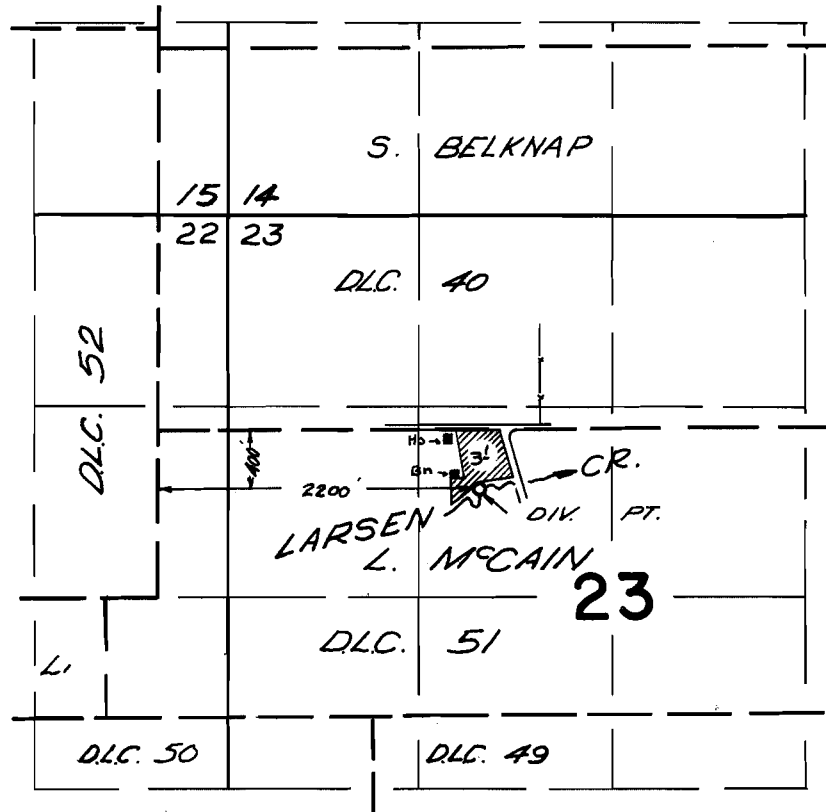

FINAL PROOF SURVEY
UNDER

Application No. 40068... Permit No. 29749...
IN NAME OF

RICHARD L. HOCKETT

Surveyed April 26 1966, by V. GARNER...