


T.3S. R.1W. W.M.

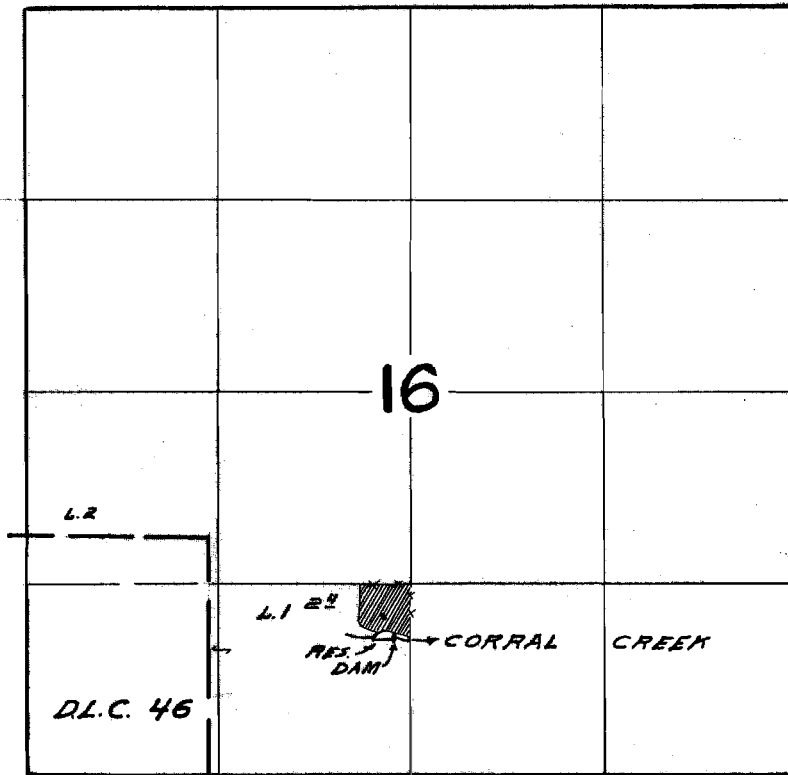

DISREGARD
DLC 46
BRS
9-2-77

DIVERSION POINT LOCATED 380 F.S. E 120 F.W. FROM
NE. CORNER SE 1/4 SW 1/4 SEC. 16

FINAL PROOF SURVEY
UNDER

Application No. ³⁷¹²¹ ~~R-37075~~ Permit No. ²⁷⁶⁰² ~~R-2683~~
IN NAME OF

Vernon D. Amell

Surveyed Oct 21, 1966, by W. L. Ruppert