


T.3S. R.1W. W.M.

DISREGARD
DLC 46
BRS
9-2-77

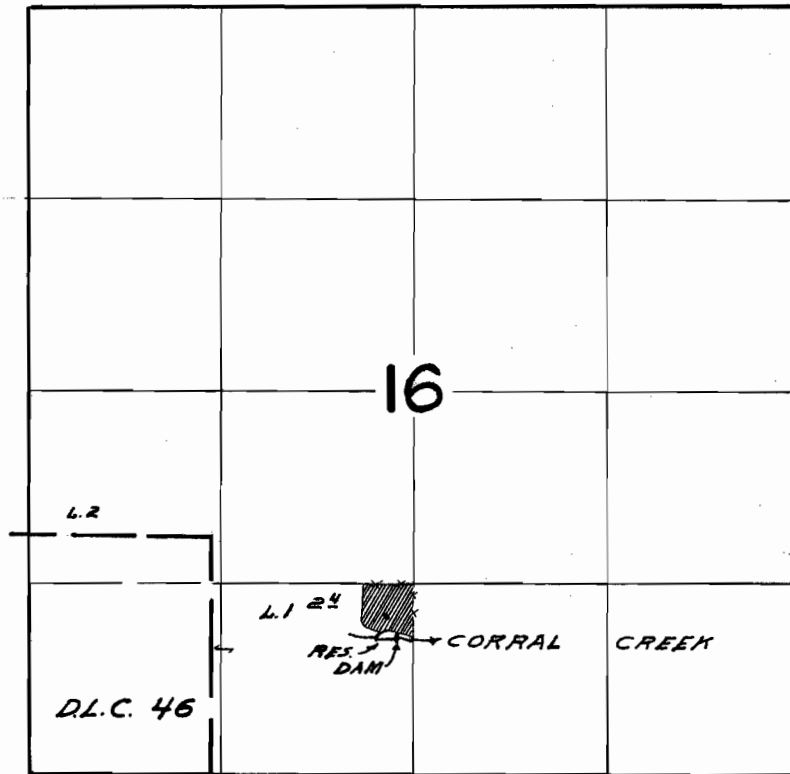

DIVERSION POINT LOCATED 380 FE S. & 120 FE W FROM
NE. CORNER SE 1/4 SW 1/4 SEC. 16

FINAL PROOF SURVEY UNDER

Application No. 37121 Permit No. 27602
R-37075 R-2683
IN NAME OF

Vernon D. Amell

Surveyed Oct 21, 1966, by W.J. Ruppert