


T.6S.R.2E.W.M.

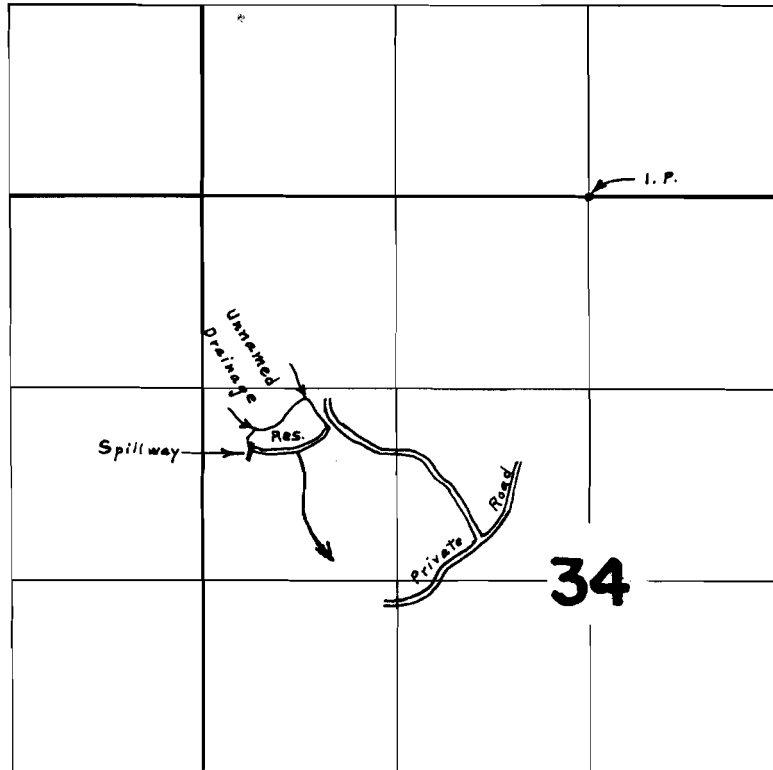

Div. Pt. 1740' S. & 2000' W. from the N 1/4 Cor. Sec. 34

FINAL PROOF SURVEY
UNDER

R-38266 R-3197
Application No. 38267 Permit No. 28513
IN NAME OF

WILLARD G. DEARDORFF

Surveyed Sept 22 1966, by L. E. Gould