


T.3S.R.2 E.W.M.

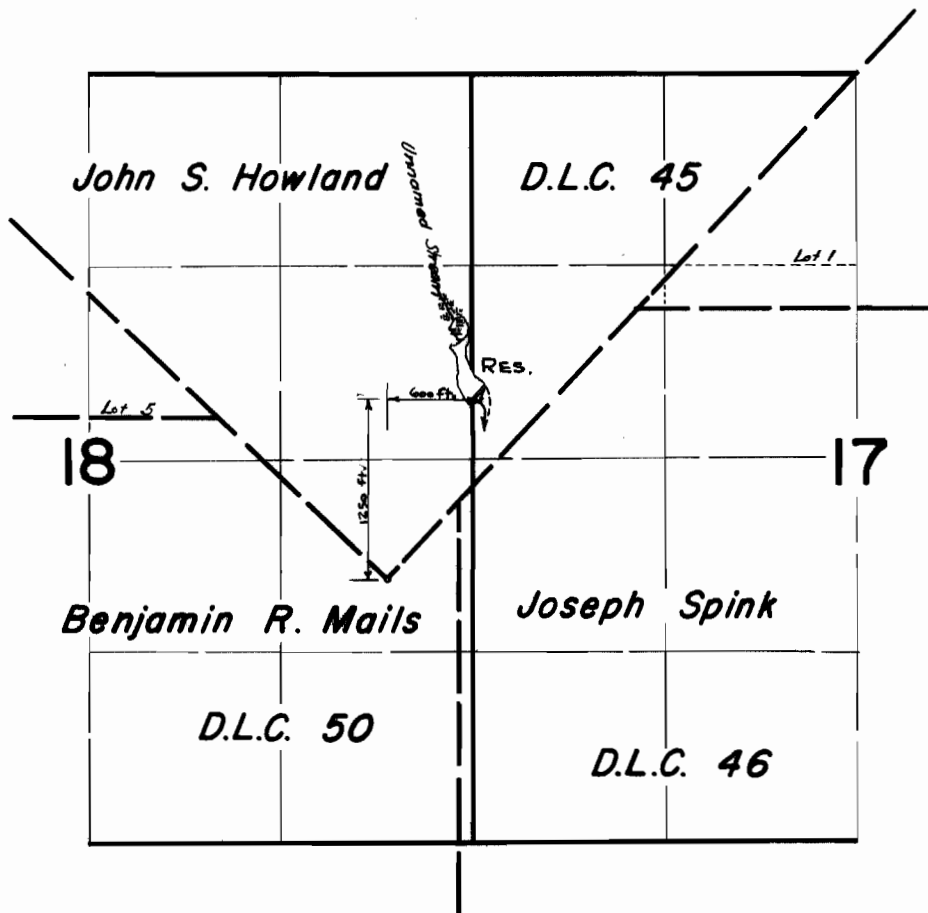

**FINAL PROOF SURVEY**  
UNDER

R-39274                      R-3893  
Application No. 39158      Permit No. 29215  
IN NAME OF

**WALTER E. DILLON**

Surveyed August 18 1965, by *[Signature]*