


T.3S.R.2 E.W.M.

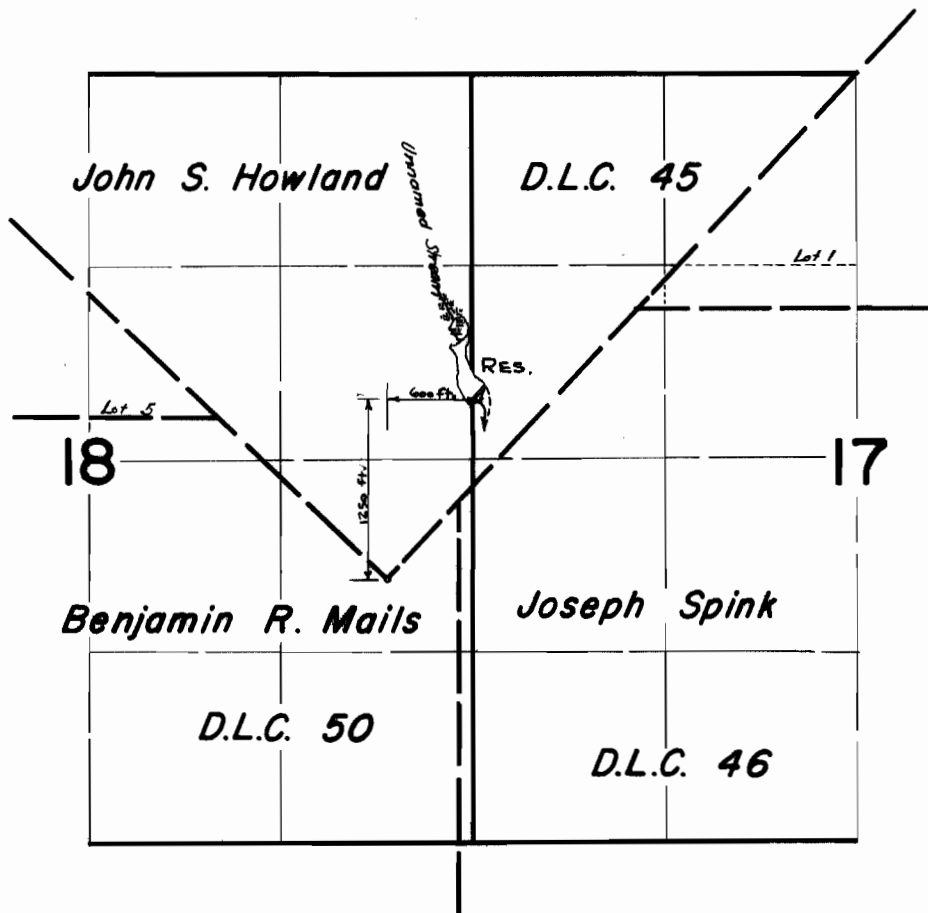

FINAL PROOF SURVEY
UNDER

R-39274 R-3893
Application No. 39158 Permit No. 29215
IN NAME OF

WALTER E. DILLON

Surveyed August 18 1965, by *[Signature]*