


T.1S. R.4E. W.M.

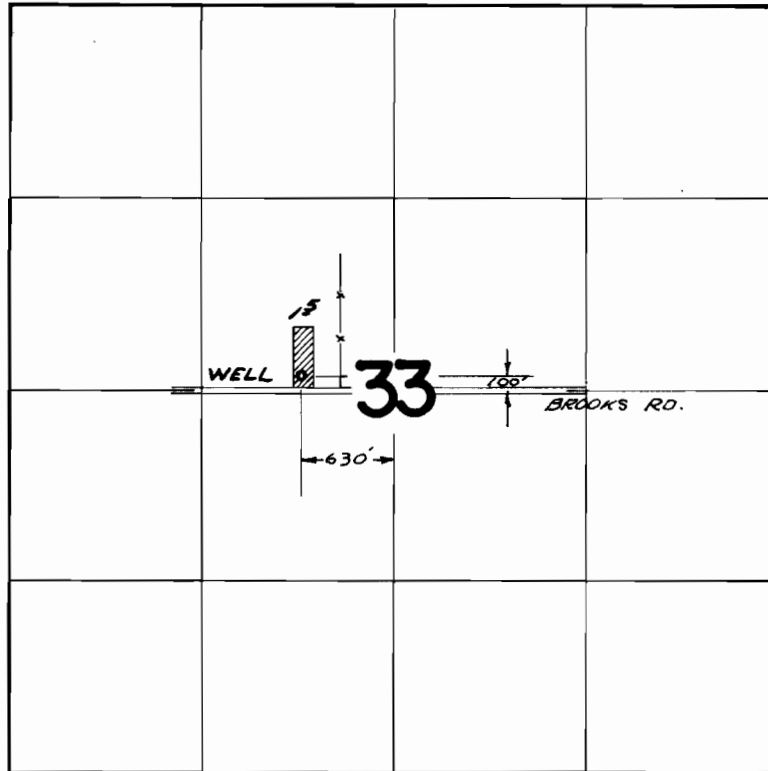

FINAL PROOF SURVEY
UNDER

Application No. G-2637 Permit No. G-2456
IN NAME OF

ROBERT T. DUPEE

Surveyed AUG. 23 1966, by V. GARNER