


T.2S. R.3E. W.M.

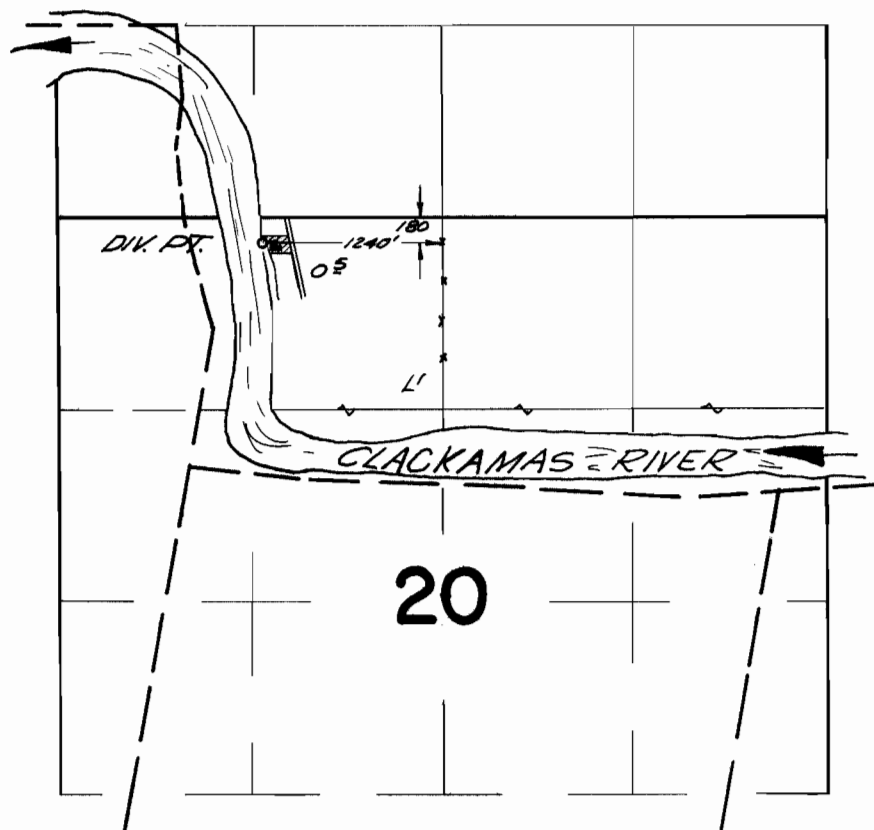

FINAL PROOF SURVEY UNDER

Application No. 38248 Permit No. 28505
IN NAME OF

HERBERT LEE and GLADYS HULSEY

Surveyed Aug. 22, 1966, by V. GARNER