


T.3S. R.4E. W.M.

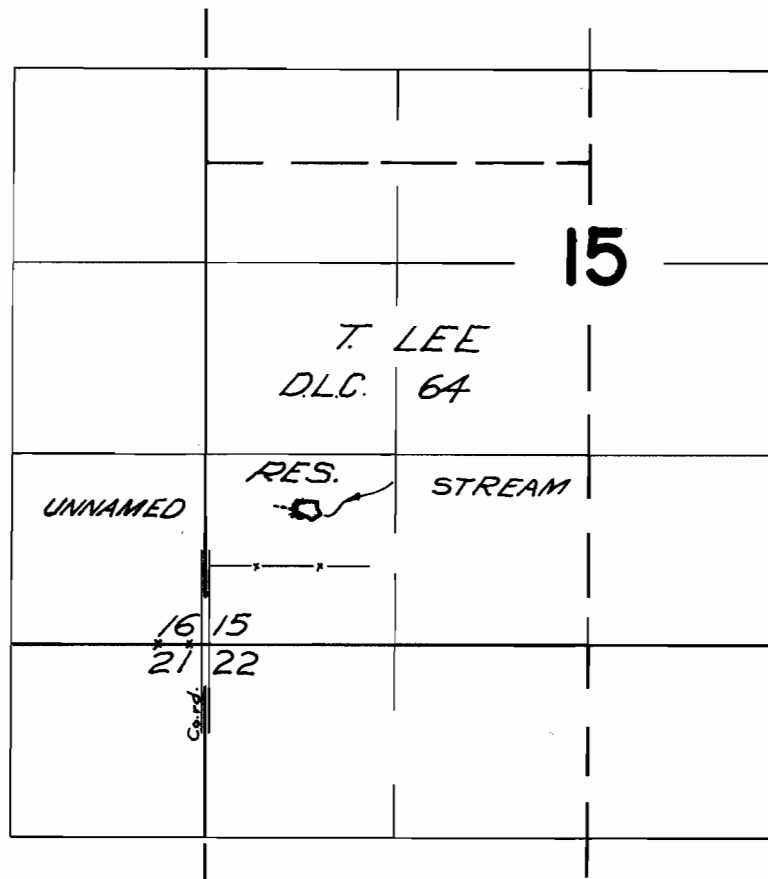

FINAL PROOF SURVEY
UNDER

Application No. R37711 Permit No. R2994
IN NAME OF

H.C. KRUGER

Surveyed Aug. 25 1966, by V. GARNER